

AVE.

VINE


28th

29th

30th

SHIFT - ORA LOCATION
MAP CORRECTION

40.60
26.23

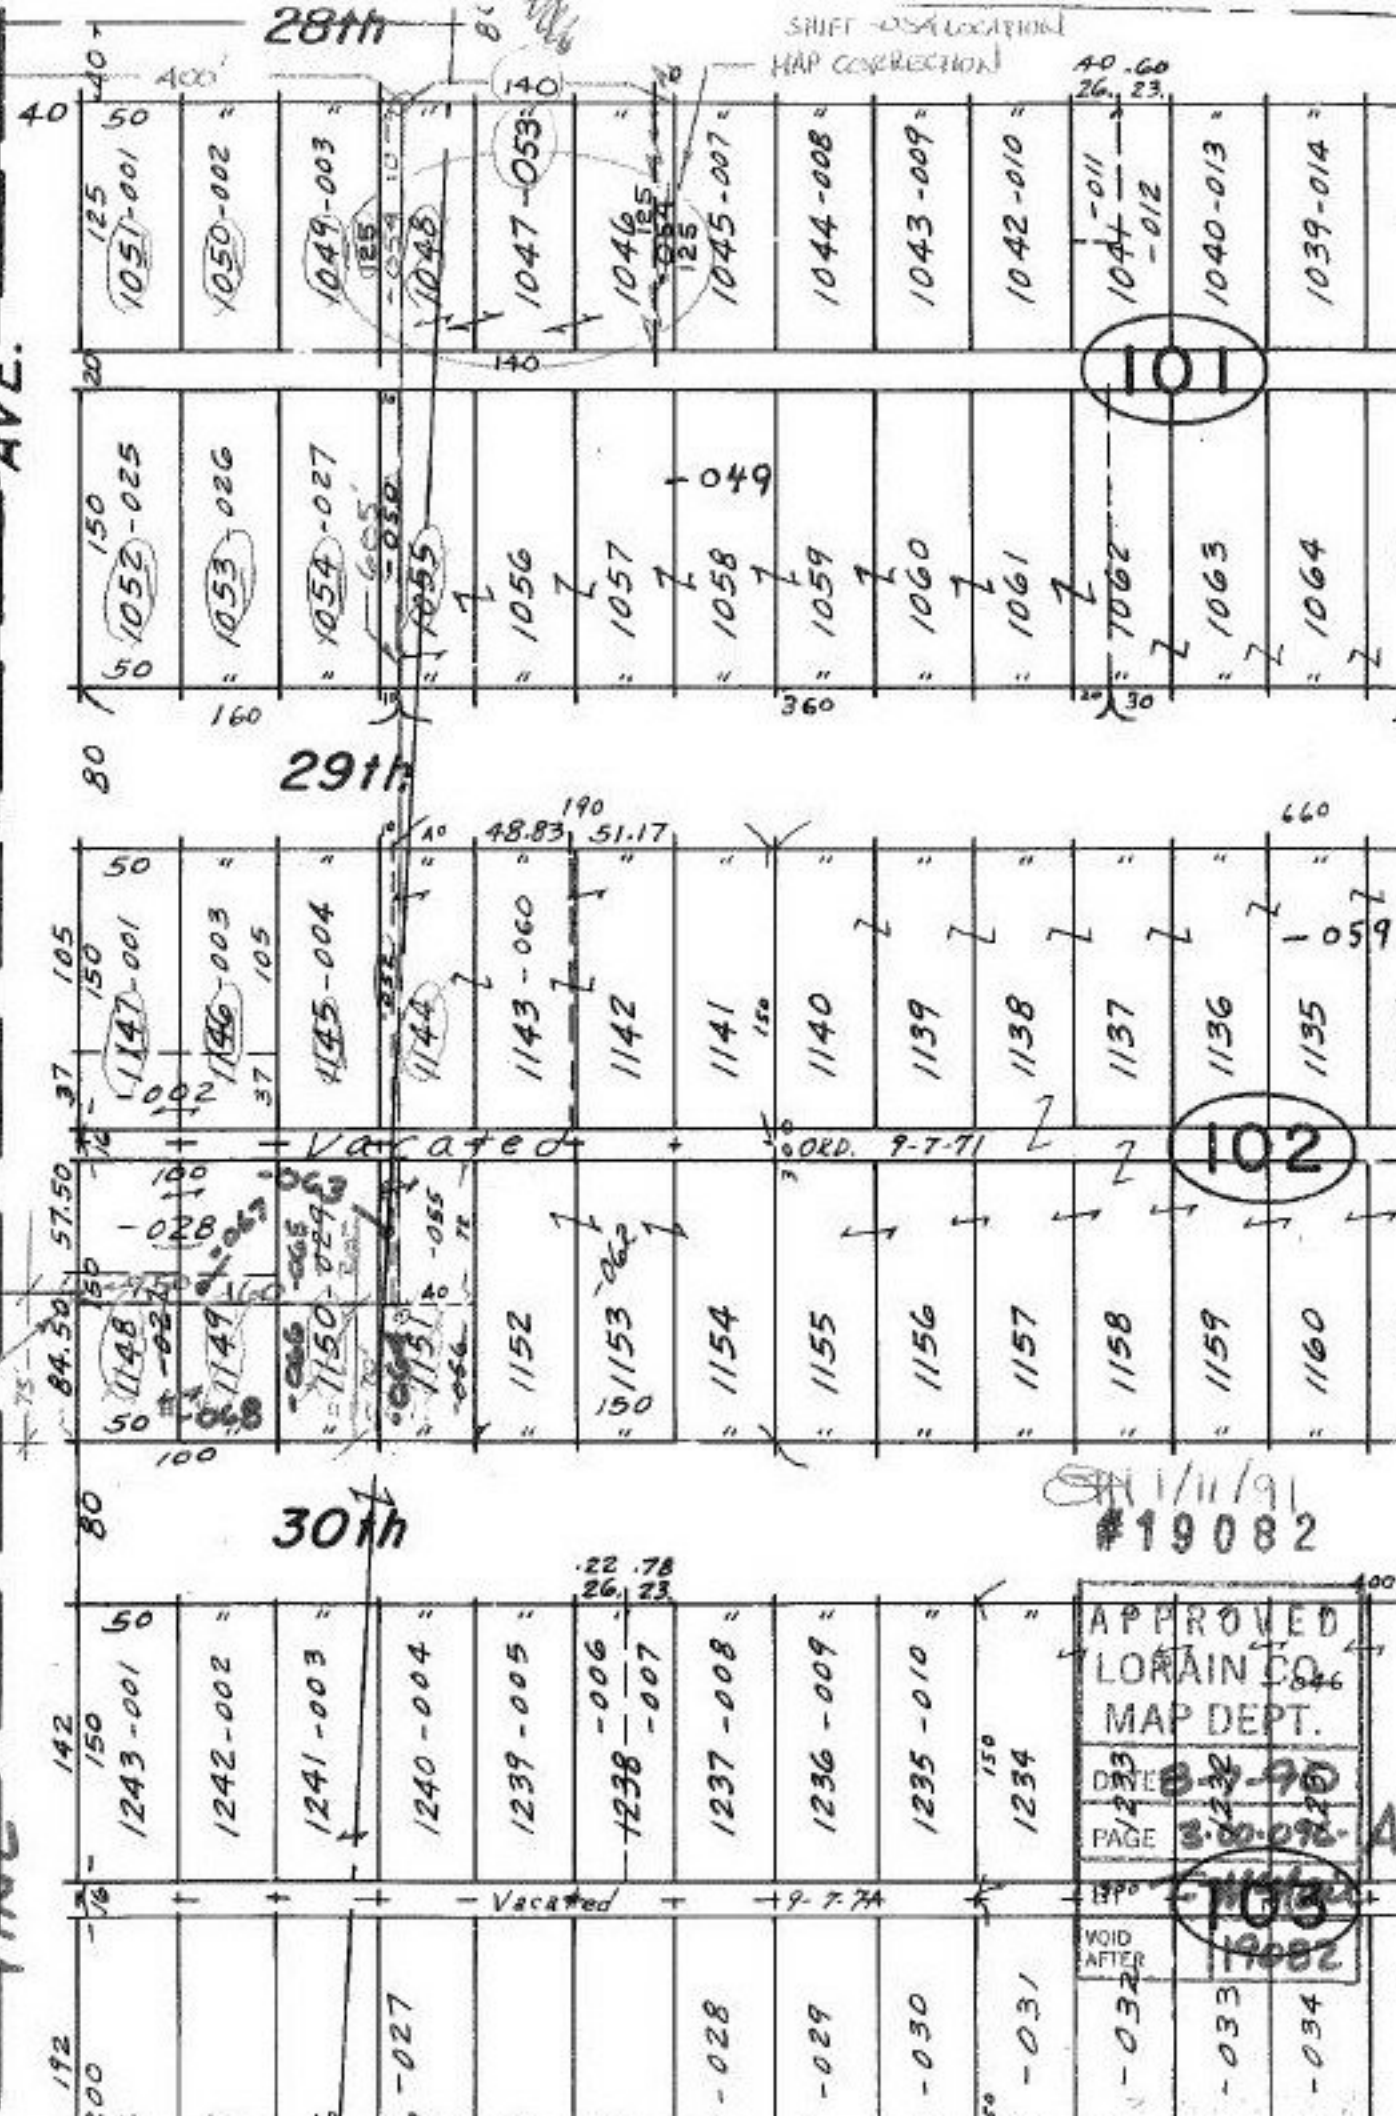

APPROVED
LORAIN CO.
MAP DEPT.
#19082

DATE 8-23-90
PAGE 3-20-90
VOID AFTER 19082