

JLE J L


Pr. 03-00-088-101-009  
Pr. 5.93 A.

1707

012

1.20 A.

076 A.

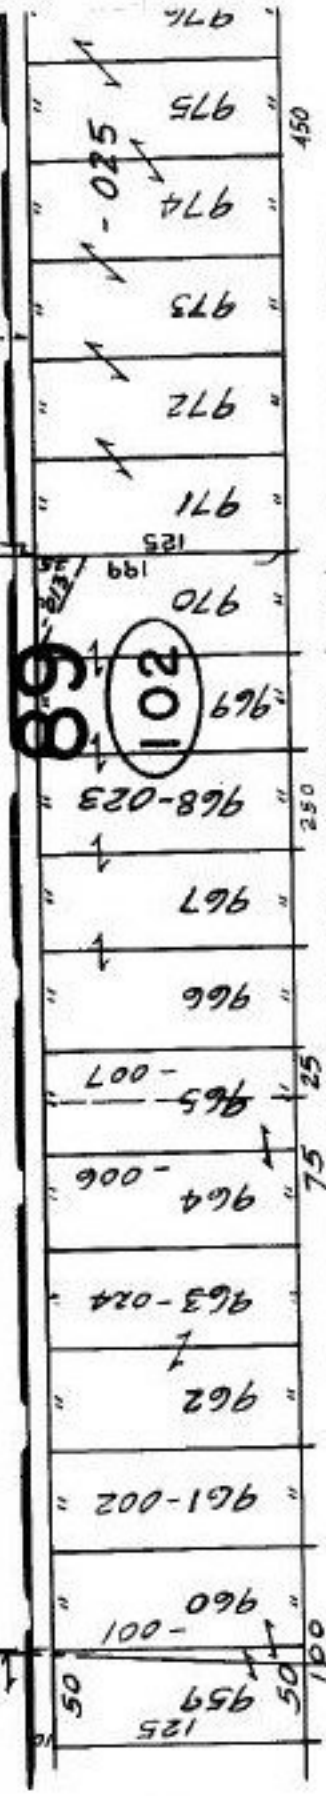


90

103

MAP CORR PER DEED VOL 1380 PG 361

28th

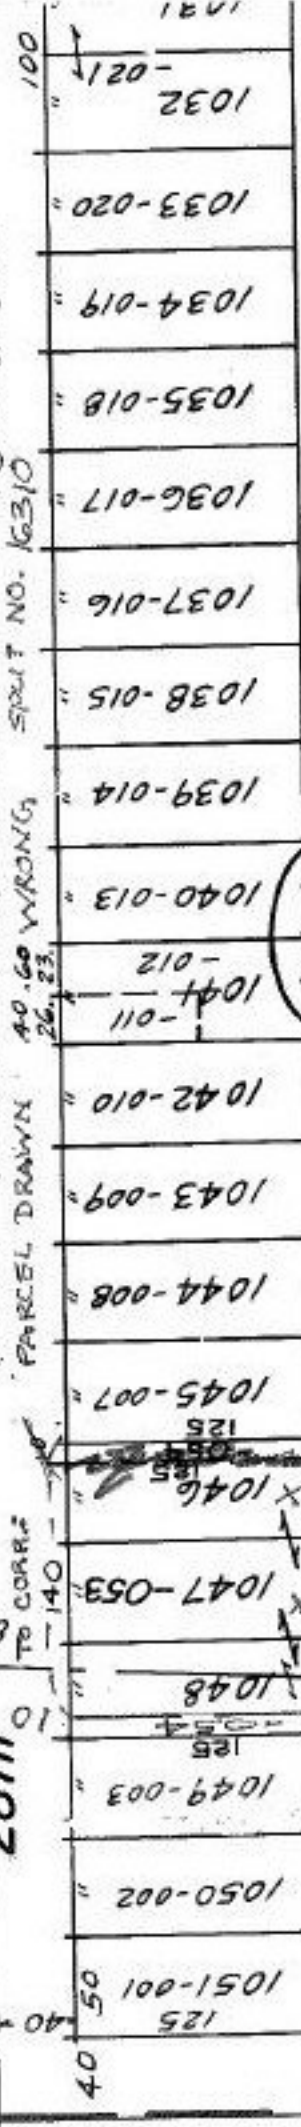


PARCEL DRAWN 40.60 WRONG SPLOT NO. 16310

TR CORRZ

101

AVE.

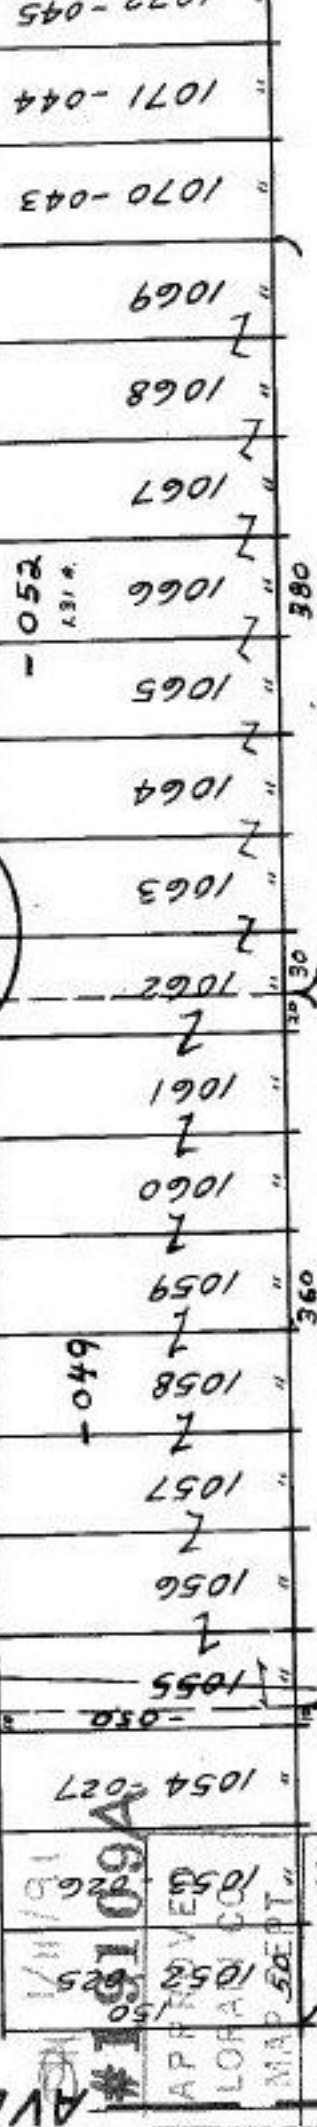

049

#19109A

APPROVED BY LORAIN CO. MAP DEPT.

DATE 8-30-90


PAGE 300-096-291h

BY CAROLYN

FRANCIS

VOID AFTER #19109A

MAP CORR.

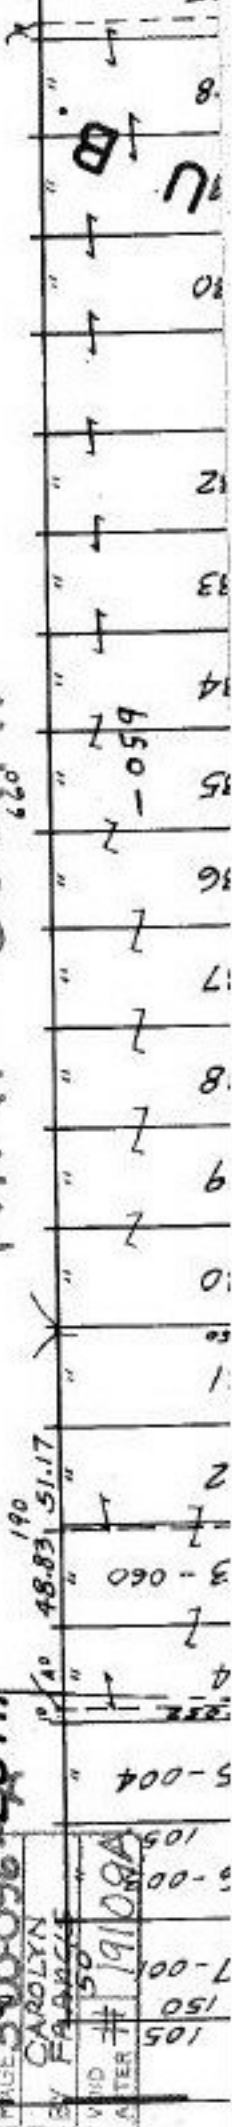

101

19109A