


815.20  
270.00  
545.20

545.20  
545.17  
.03

067 62.89  
SPUT 9.15  
REM: 53.74

275.17  
270.00  
545.17

Mon Box RUSSIA 2688.97

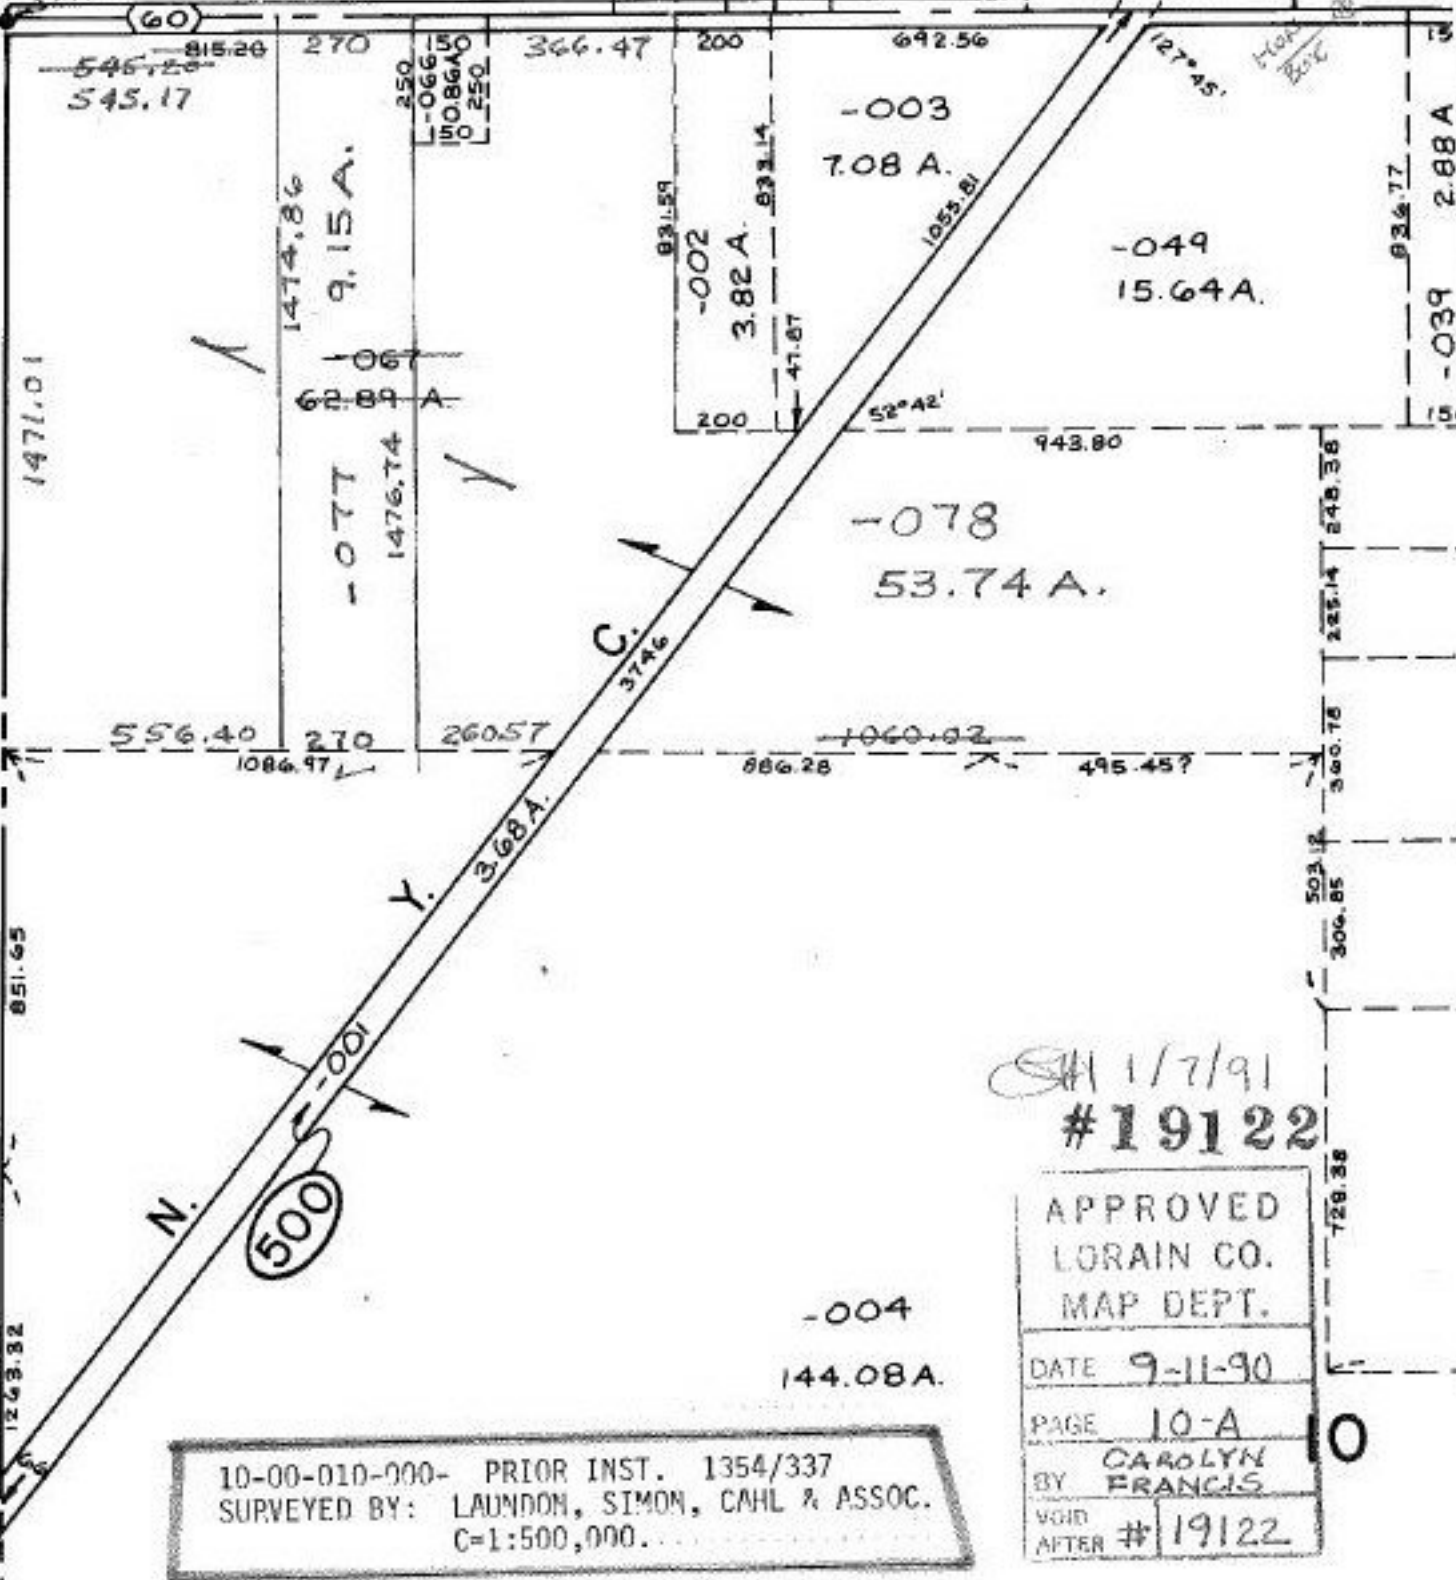

SH 117/91  
#19122

APPROVED
LORAIN CO.
MAP DEPT.
DATE 9-11-90
PAGE 10-A
BY CAROLYN FRANCIS
VOID AFTER #19122

10-00-010-000- PRIOR INST. 1354/337  
 SURVEYED BY: LAUNDON, SIMON, CAHL & ASSOC.  
 C=1:500,000.