


Pl. -001
 42.33A

Pl. -035
 Pl. 42.16A.



42.33A
~~0.17A~~
 42.16A

COLUMBIA WEST RIVER RD.

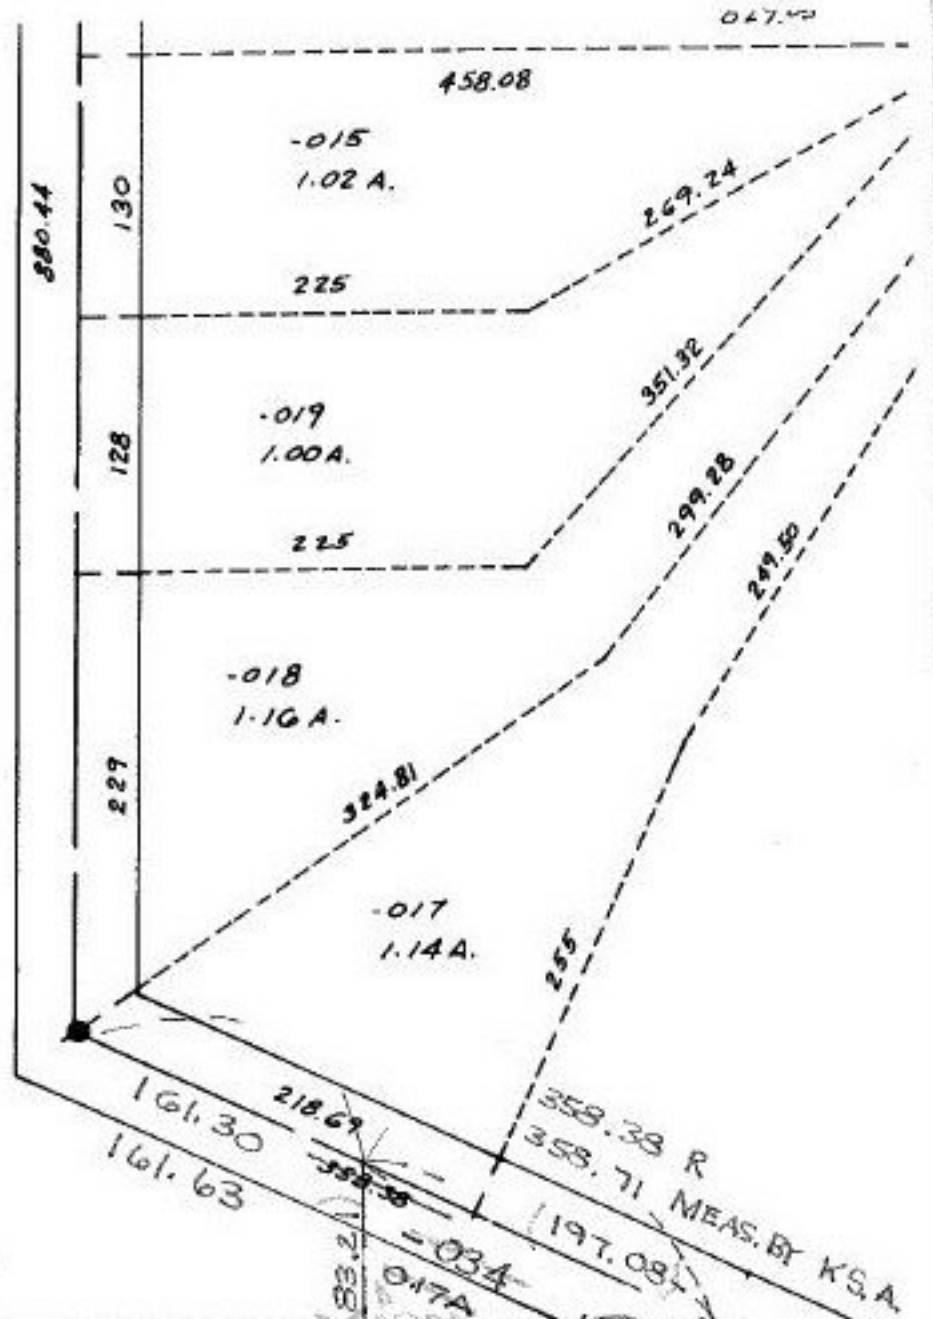


PRIOR DEED NOT
 SURVEYED 1303/843

SPLIT
 Comb.

71.65
 47.00
 118.65
 Pl. -026
 Pl. 11.44A.

0.17 (C=111,111)
 1.01
 1.18
 1.17 PER
 SURVEY 65-A

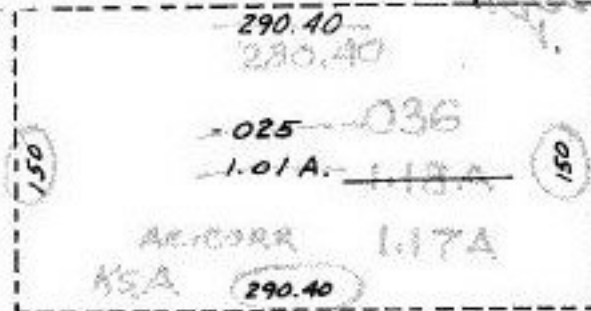

SH 2/14/91
 #19129

APPROVED
 LOBAIN CO.
 MAP DEPT.
 DATE 9-17-90
 PAGE 1200-054B
 BY CAROLYN FRANCIS
 MOD # 19129
 AFTER

12-00-054-000- PRIOR INST. 1303/843 SPLIT
 1200/35 COMB.
 PRIOR INST. Pl. -005 COMB.
 SURVEYED BY: KS. A. C=1: 52,681 SPLIT
 C=1:111,111. COMB. Pl. 12.45A.