


09-00-076-104- PRIOR INST.O.R. 51/679  
 SURVEYED BY: LAUNDON, SIMON, CAHL &  
 ASSOC. C=11NF.

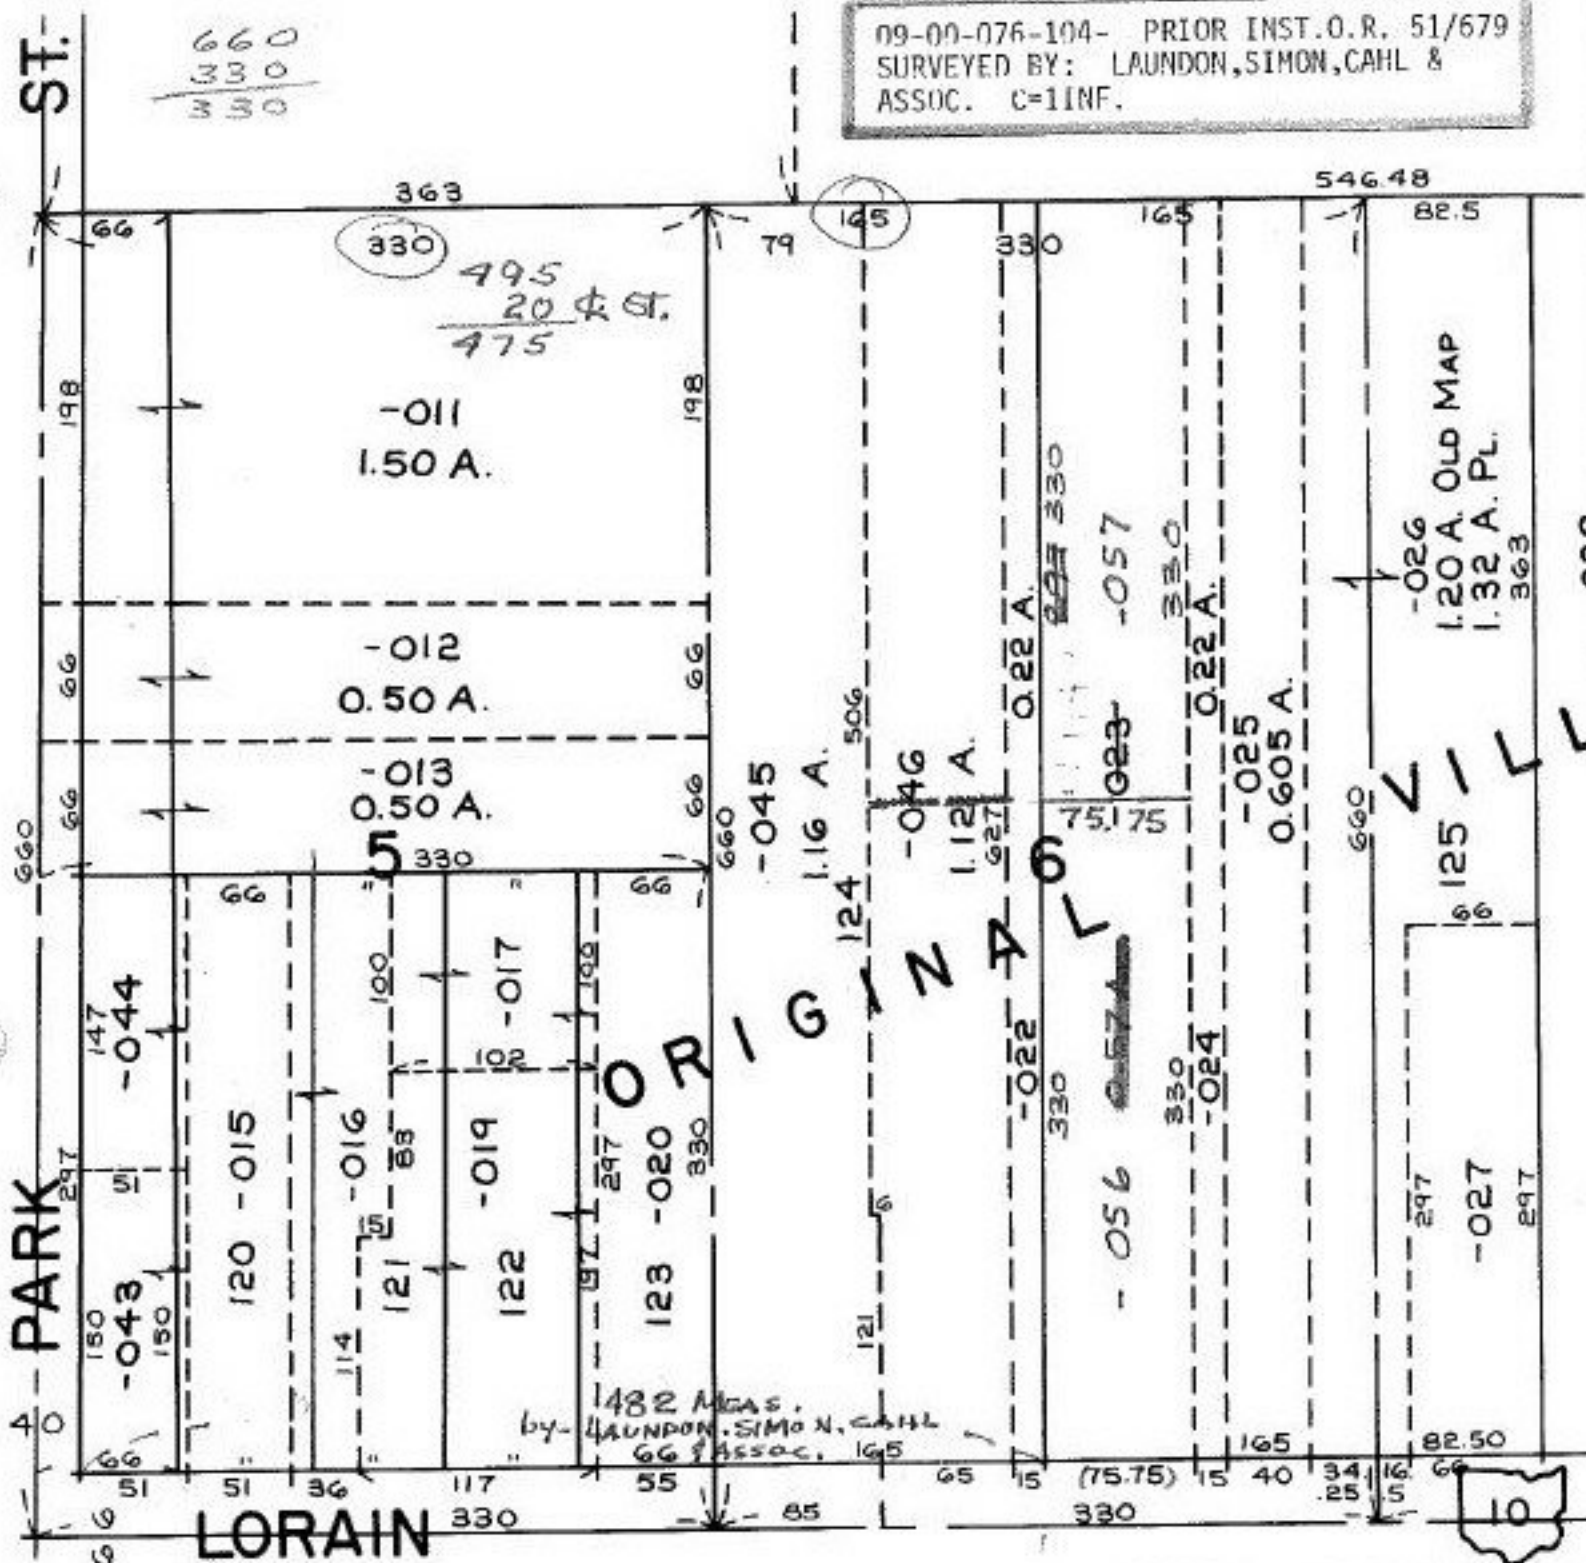


660  
 330  
 ---  
 330

495  
 20 ft. St.  
 ---  
 475

1482 MEAS.  
 by LAUNDON, SIMON, CAHL  
 & ASSOC. 1985

~~495~~ ~~20~~ ~~475~~  
 475-CALC.  
 482 MEAS.  
 7 FEET

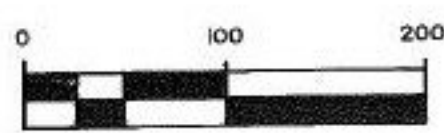

DIACCIA TWD

SEE 9-00-086  
 4/25/91  
 #19149  
 APPROVED  
 LORAIN CO.  
 MAP DEPT.  
 DATE 10-11-90  
 PAGE 9-00-076-B  
 BY CAROLYN  
 FRANCIS  
 VOID #19149