

COOPER FOSTER PARK

RD.

4.88 A	625.25
1.22 A	240.28
3.66 A	334.97

5-00-040-B

329

-074
3.44 A.

NOV 29 1997

#19155

APPROVED
LORAIN CO.
MAP DEPT.

DATE 9-27-90

PLAN 500-040-B

BY CAROLYN
FRANCIS

VOL:
AFTER # 19155

150

628.40

179


110

ROUTE 58-02

ROUTE

STATE

#18293
#18306

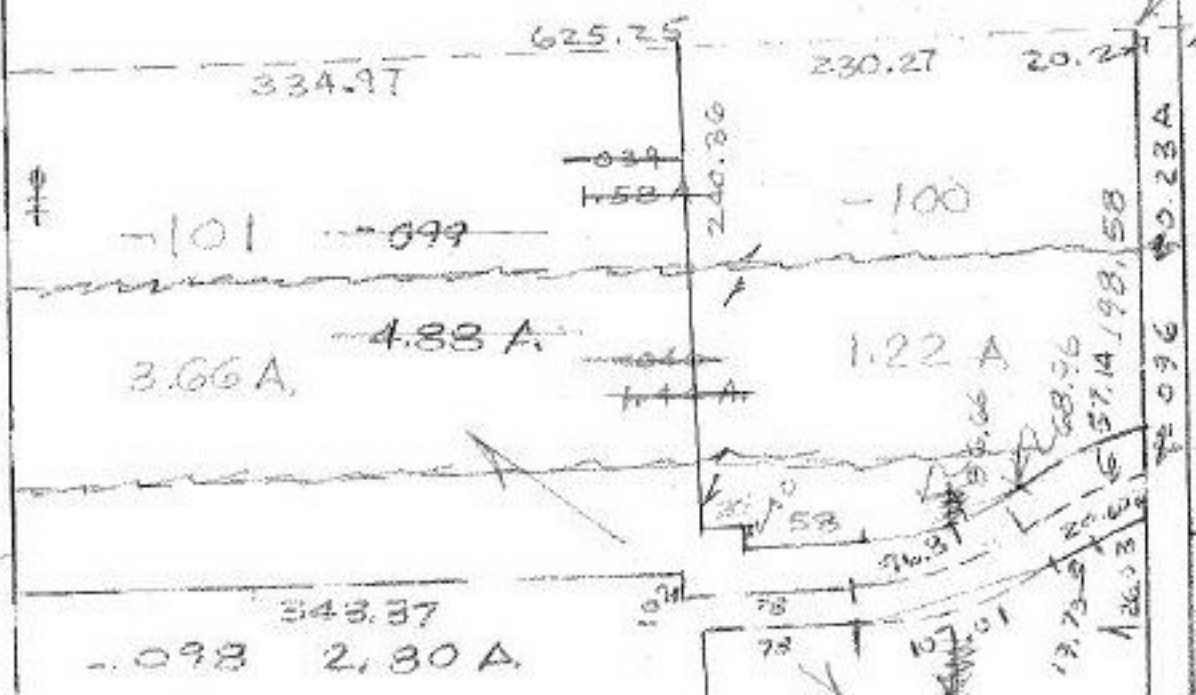

343.37
2.30 A

102

78

107

17.73

20.06

126.03

400

110

179

150

628.40