

1.58 A.

19158

Pt. -010
Pt. 6.23 A.

CANNOT DETERMINE WHAT
-013 PARCEL FIRST DESCRIPTION
1.32 A. COVERS. Frank Colbert
Pt. -010
Pt. 6.23 A.

10 INTERSTATE 90


10

103

103

Sta. 672+89.32 LOR 254
Sta. 68+80.12 LAKE AVE.

-011
1.37 A.

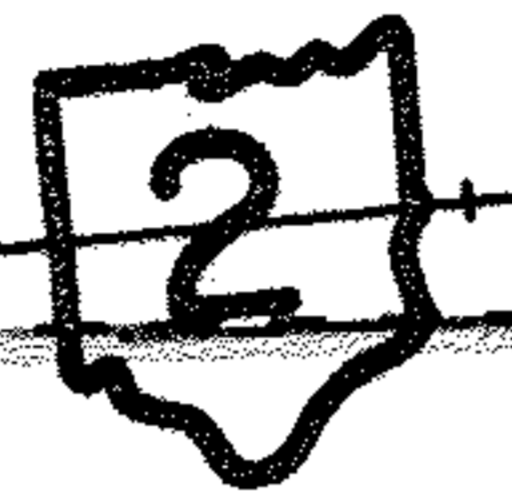

Pt. -016
Pt. 2.33 A.

Pt. -016
Pt. 2.33 A.

-015
1.88 A.

X2

-031
1.82 A

X3

INTERSTATE

DR.

-018
0.65 A.

500

#19158 2nd DESCRIPTION
-019 1.72 A. IS -018 0.65 A.

Pt. -022
Pt. 3.81 A.

A. -032
Pt. 3.81 A.

12/14/90
19158-A

-030
0.67 A.

CASSELL

APPROVED
LORAIN CO.
MAP DEPT.

DATE 10-31-90

PAGE 6-25+26 #19158-A

BY Frank Colbert 002

VOID AFTER 19158 95 A.

APPROVED
LORAIN CO.
MAP DEPT.

DATE 10-31-90

PAGE 6-25+6-26

BY Frank Colbert

VOID AFTER 19158A

DEED
CHECK

#19107
06-23-010-101-041
Pt. 11.40 A.

19158-A
-034
0.97 A.

Pt. 15
-013

Pt. 15 -013

103

1A -045

35

70
R185