

448  
25

# 1917

APPROVED  
LORAIN CO.  
MAP DEPT.

DATE 7-2-68

4-00-016-F

BY *Steelhead*




7-14-86 & S.

*8-3-86*

**103**

-003  
21.00A.

165.00  
17-01  
160.00  
158.00  
16-0  
153.99  
103.99  
15-029  
152.05  
91.15  
98.36

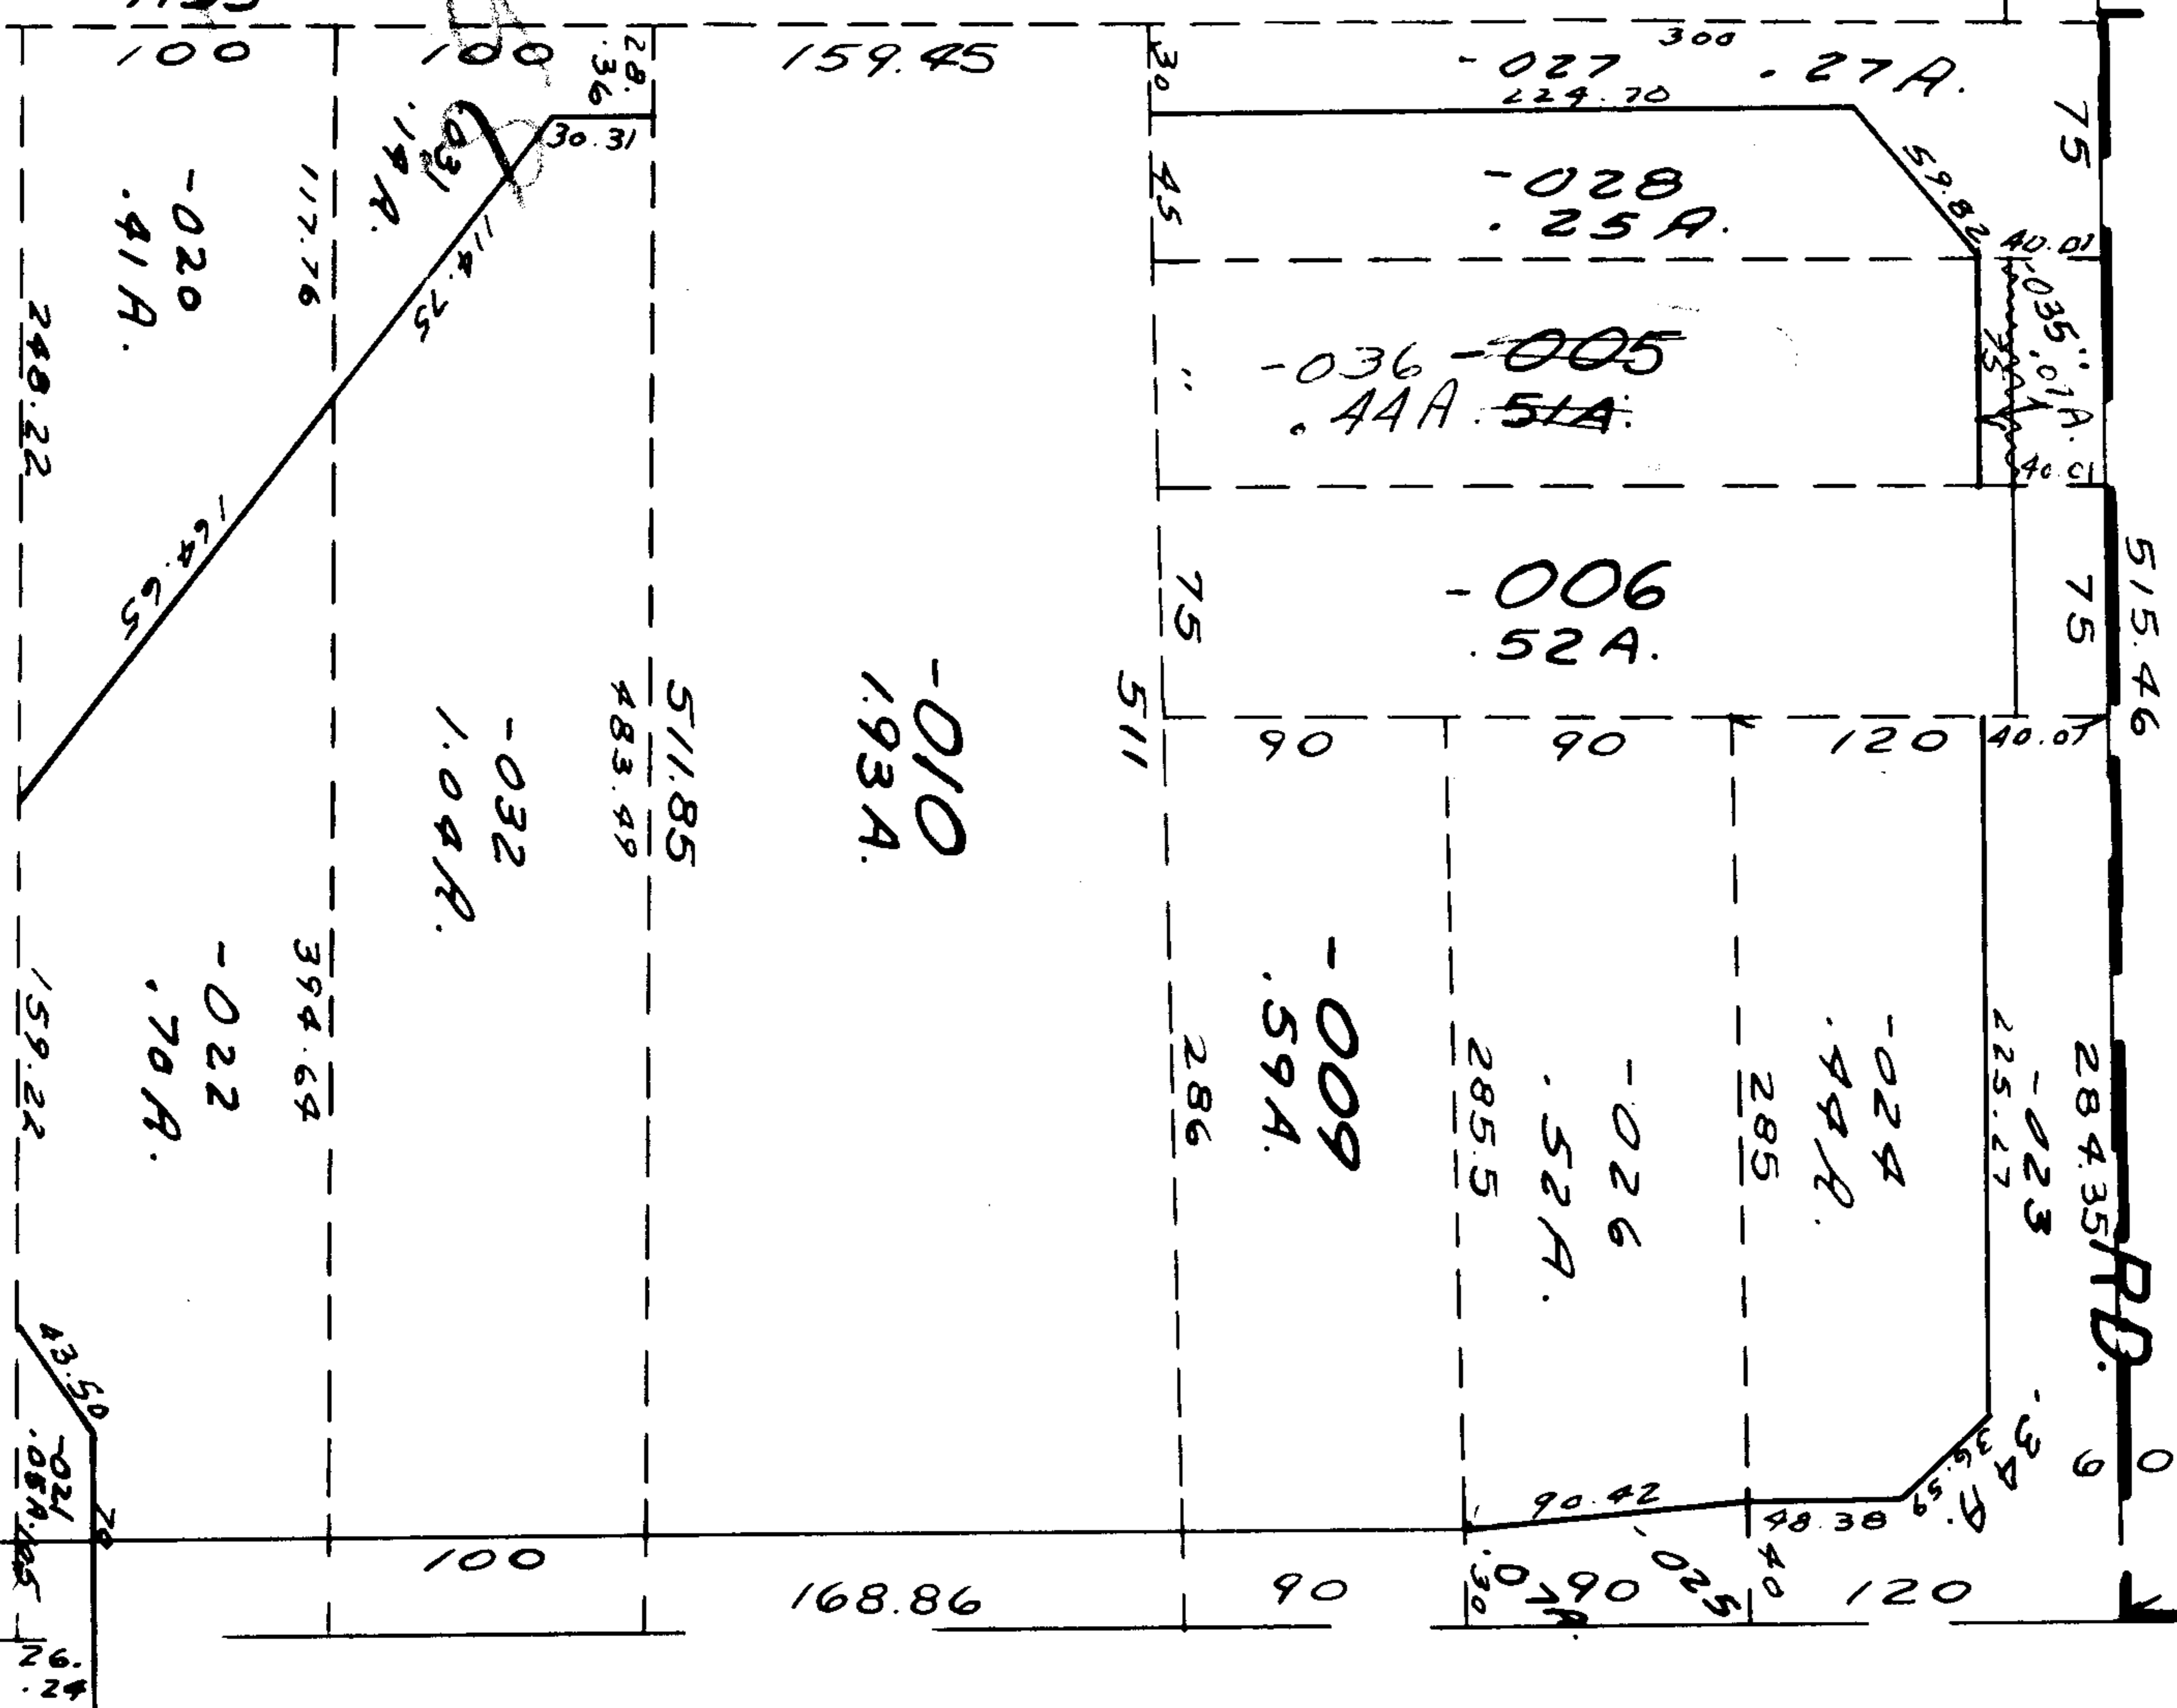

26.24

E