


SEE I-00-051-A

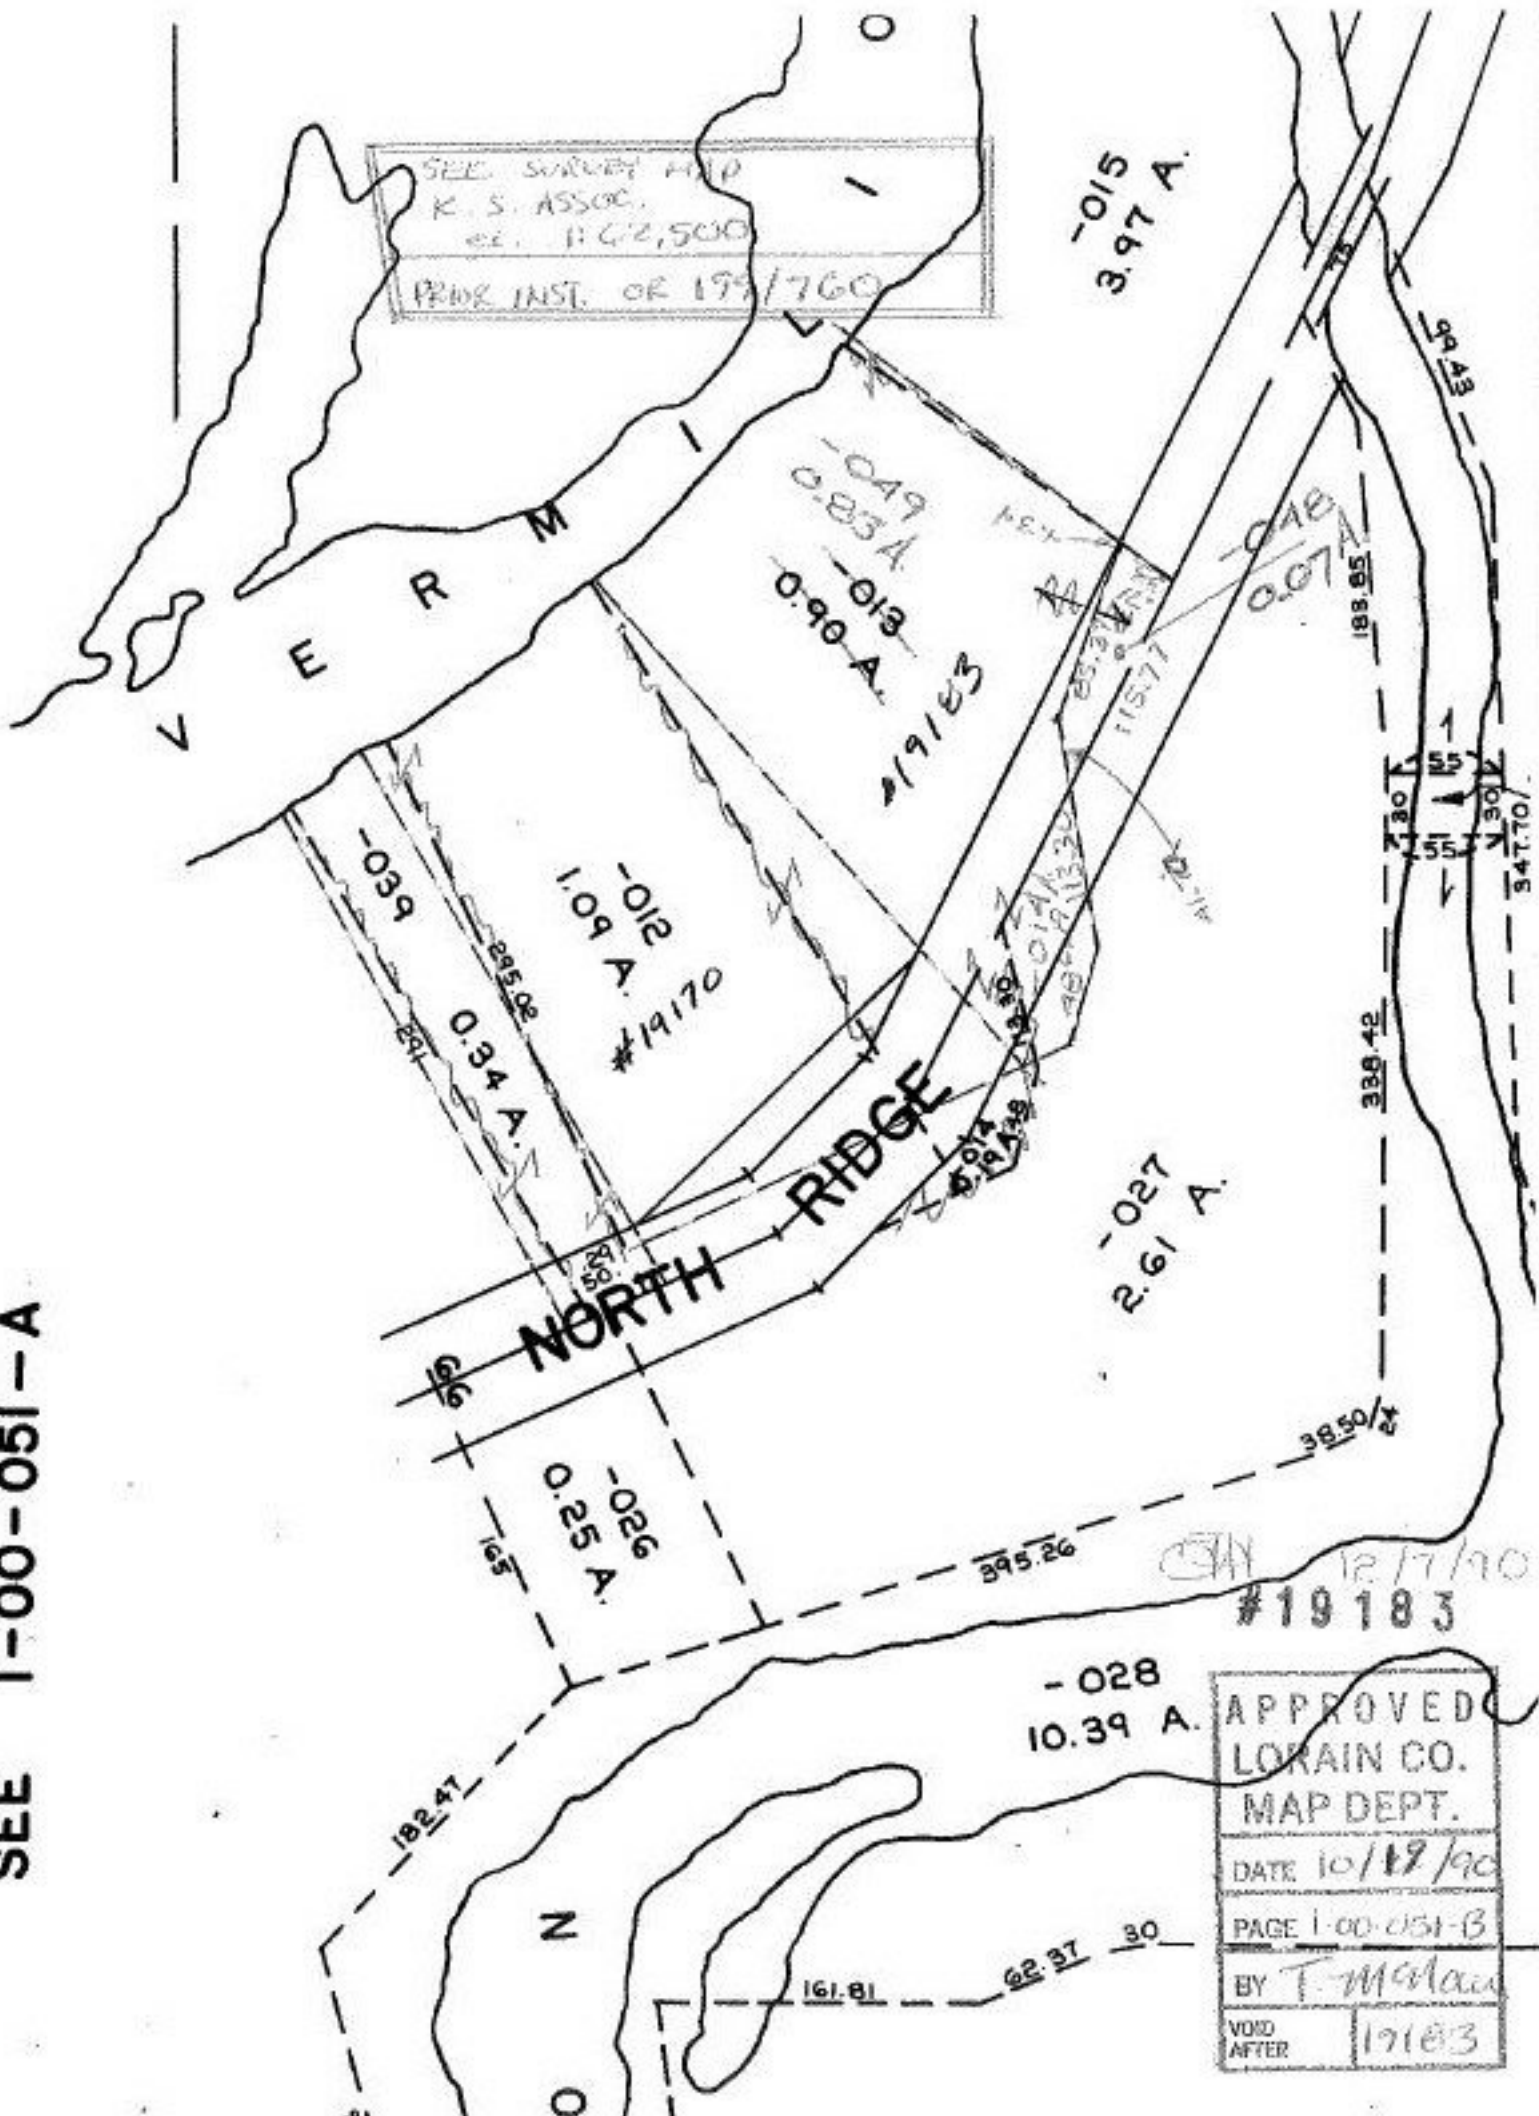

SEE SURVEY MAP
K. S. ASSOC.
et. 1:62,500
PRIOR INST. OF 1951/760

3.97 A.
-015

0.83 A.
-049
-013
0.90 A.
#19183

0.67 A.
-048

1.09 A.
-012
#19170

0.34 A.
-039

NORTH RIDGE

2.61 A.
-027

0.25 A.
-026

10.39 A.
-028

APPROVED
LORAIN CO.
MAP DEPT.

DATE 10/19/90

PAGE I-00-051-B

BY T. McNamee

VOID AFTER 19183

12/7/90
#19183