


SEE 11-00-018-A

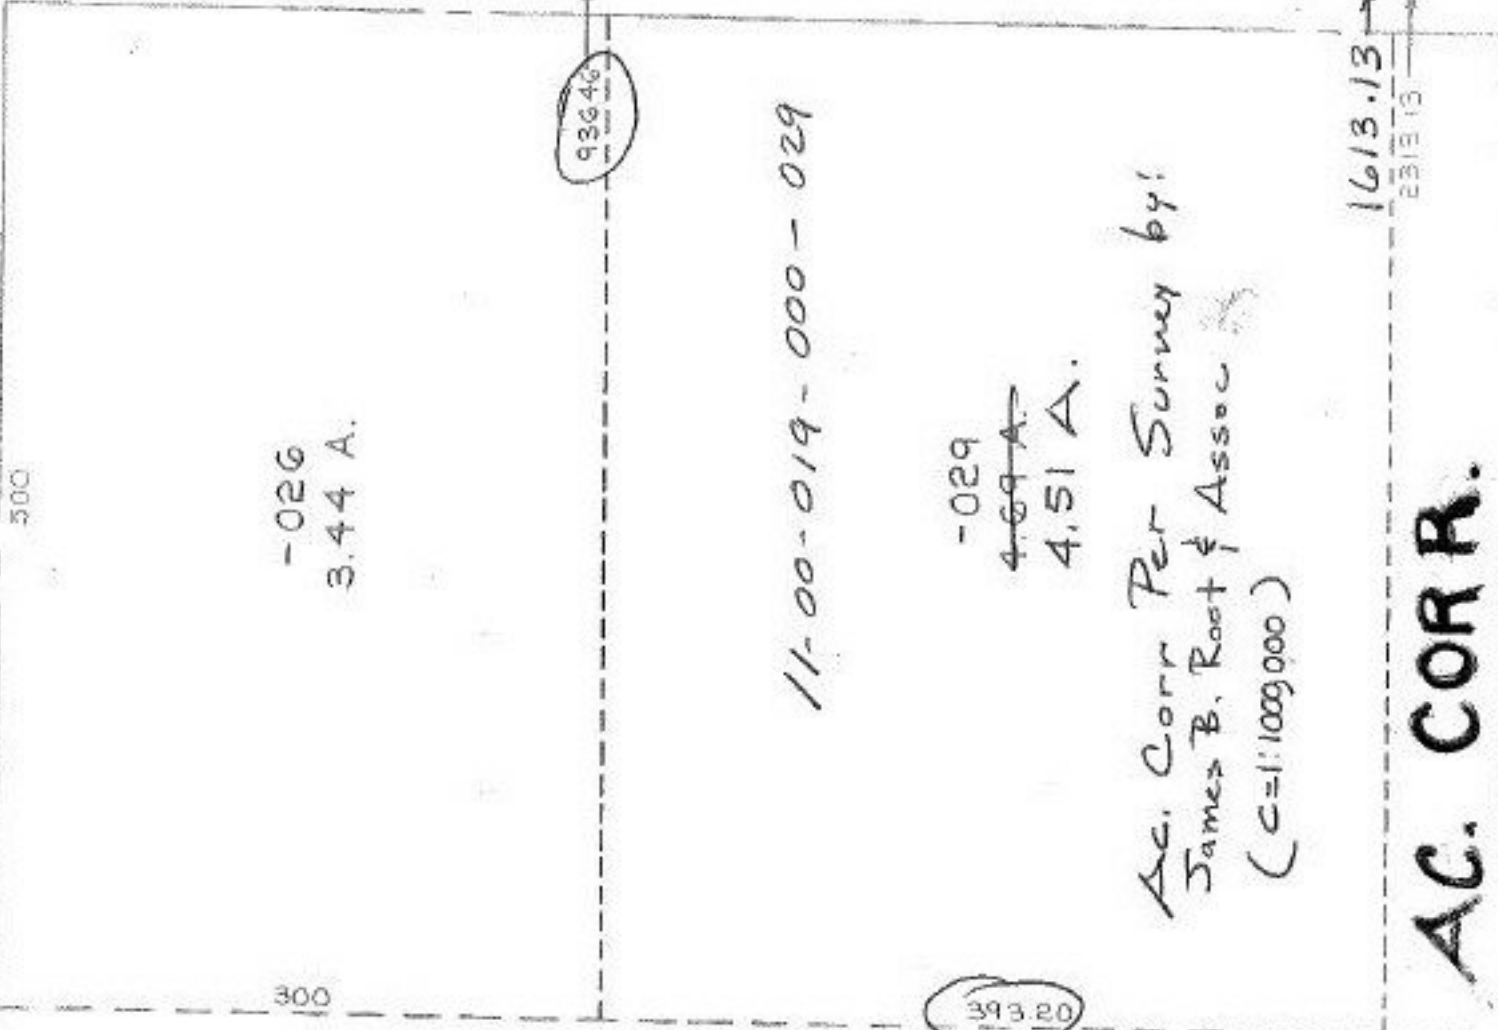

-026  
3.44 A.

11-00-019-000-029

-029  
~~4.69 A.~~  
4.51 A.

Ac. Corr Per Survey by:  
James B. Root & Assoc  
(C=1:1000000)

93646

300

393.20

1613.13  
2319.13

AC. CORR.

#19193A

APPROVED	
LORAIN CO.	
MAP DEPT.	
DATE	10-28-90
PAGE	11-00-019A
BY	CAROLYN FRANCIS
VOID AFTER #	19193-A