


18

# MEDINA - NORWALK

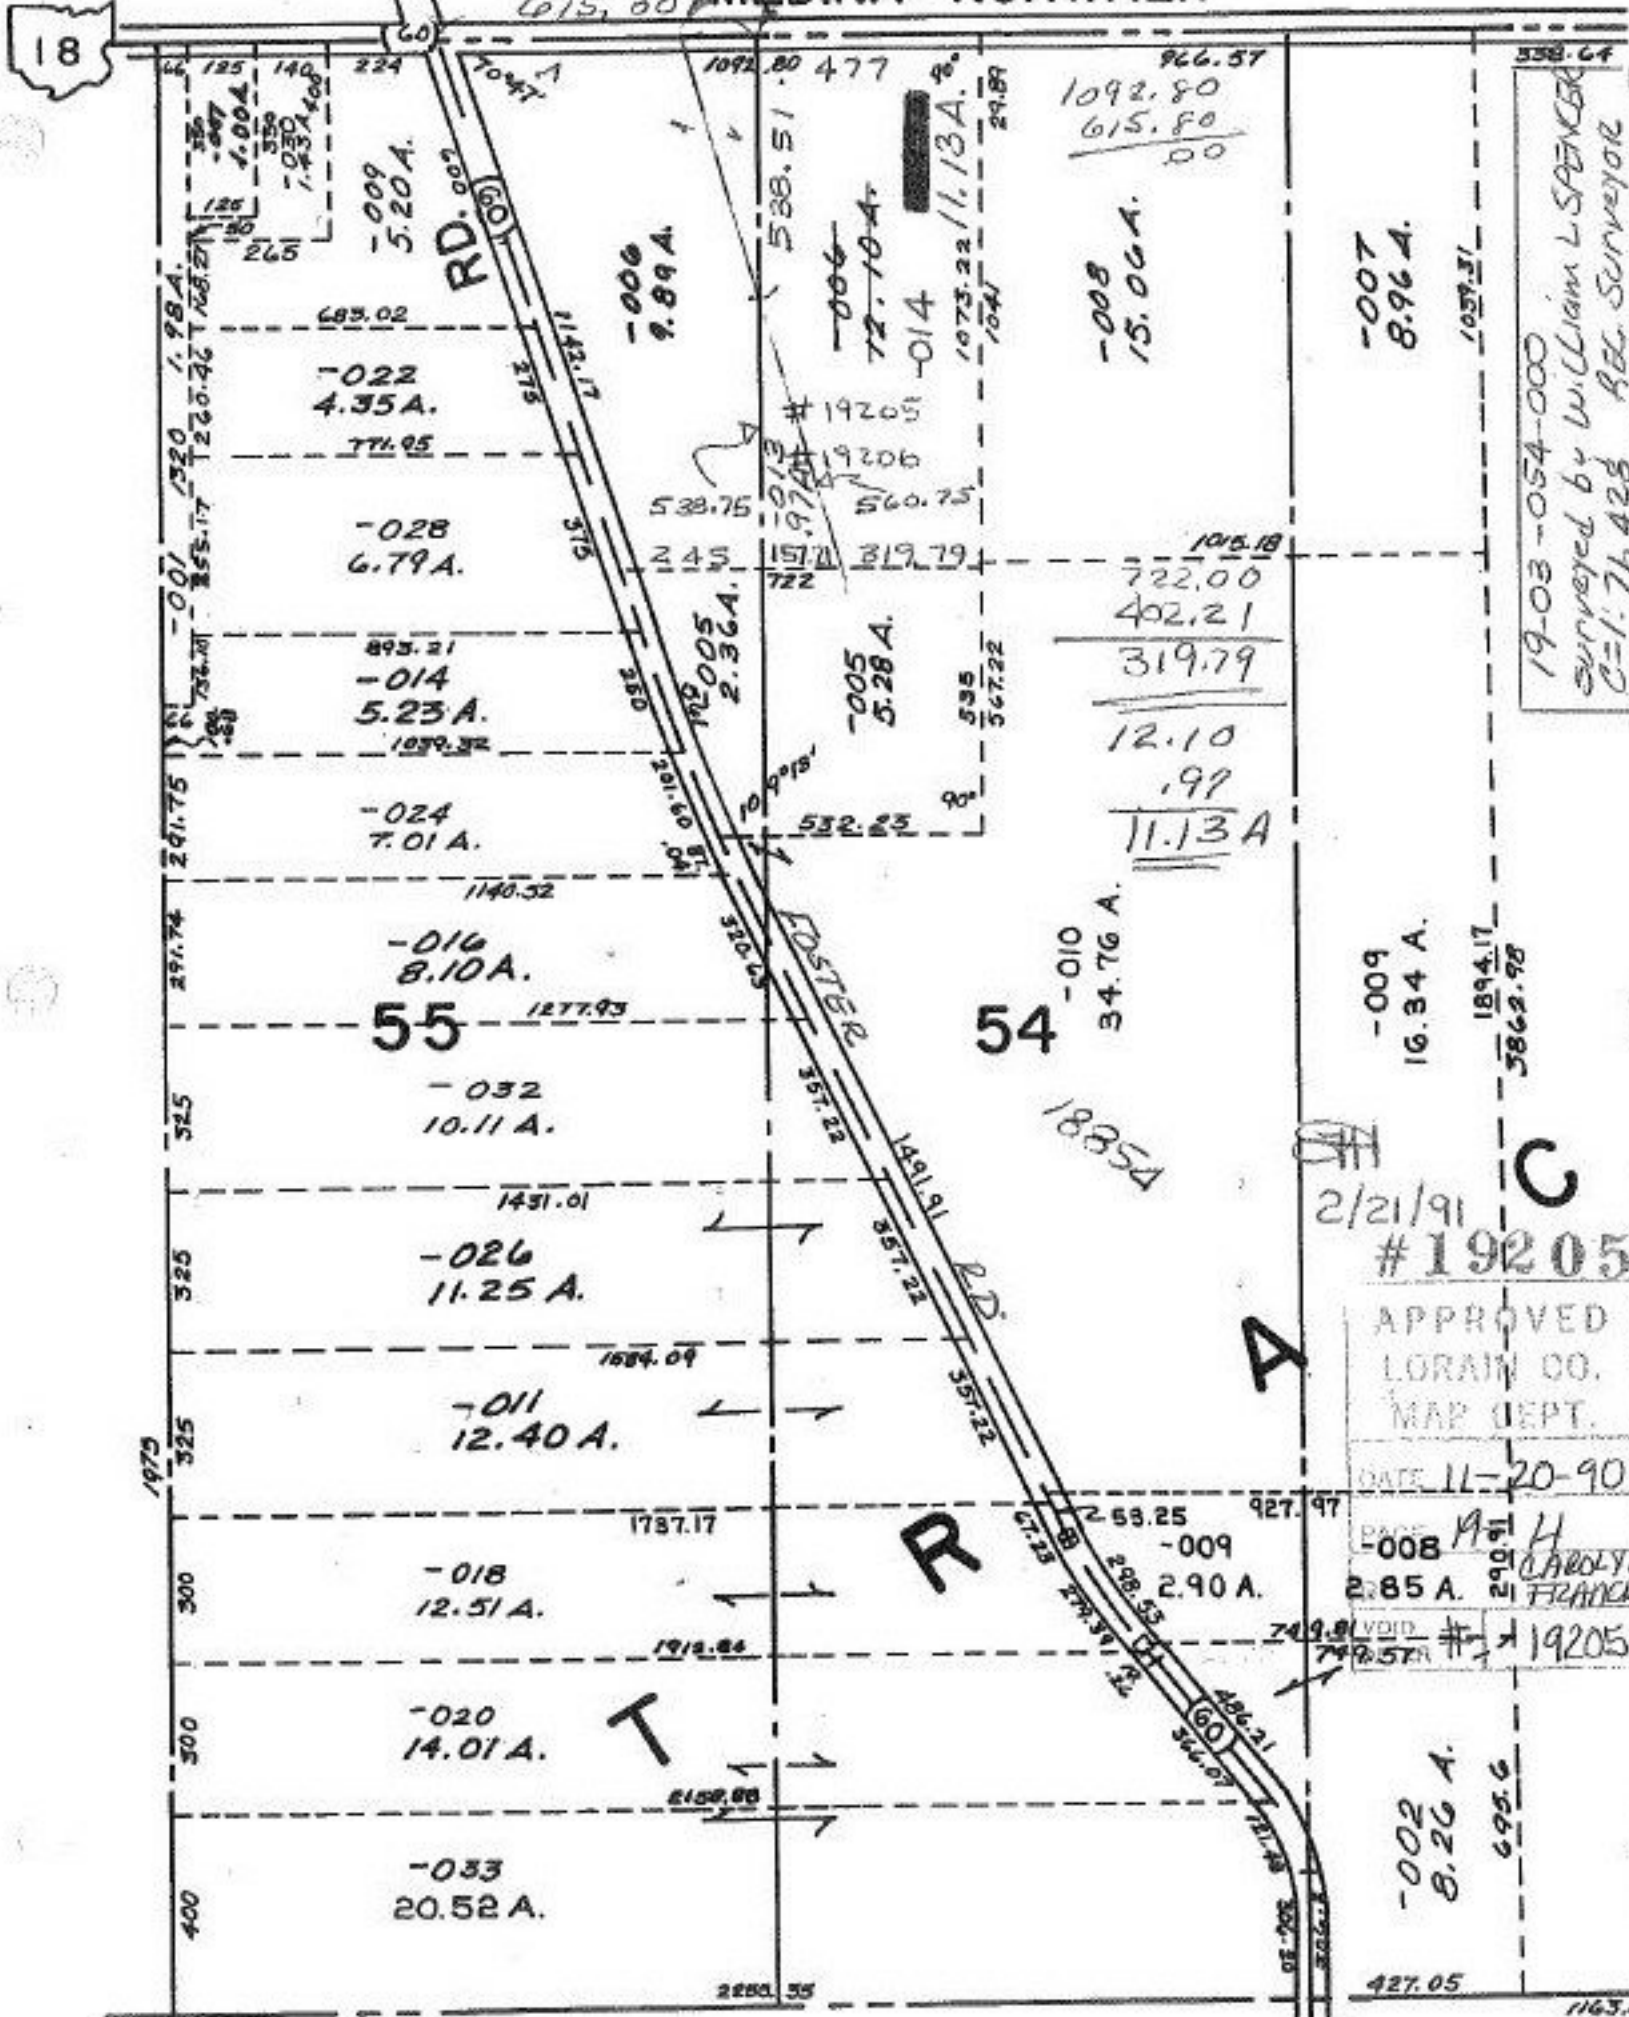

19-03-054-000  
 Surveyed by William L. SPENKER  
 C-1: 7h, 428 REG. SURVEYOR

APPROVED  
 LORAIN CO.  
 MAP DEPT.

DATE 11-20-90

PAGE 008 A of H  
 2.85 A. 290 ft  
 CAROLYN FRANKS

VOID # 19205

-002  
 8.26 A.  
 695.6

427.05

2/21/91  
 #19205  
 C

966.57  
 1092.80  
 615.80  
 00

105.18  
 722.00  
 402.21  
 319.79  
 12.10  
 .97  
 11.13 A

-010  
 34.76 A.  
 18354

-009  
 16.34 A.  
 1894.17  
 3862.98

-007  
 8.96 A.  
 1039.31

1163.81  
 -011

615.80

1092.80 477

538.51

12.10 A

-014

1073.22 / 1.13 A.

1041

29.89

1420.51

1420.51

560.75

319.79

722

535

567.22

532.23

1099.75

532.65

357.22

1491.91

357.22

857.22

357.22

1491.91

357.22

857.22

357.22