

3245.88

435.00
8-017 1.00A
435.00

-002
9.96

840

-021
10.00

841.91
291

259.91
-027
2.75 A.
249.89
-004
1.00 A.
140.30
291

890.73
-001
10.07 A.

161

-039
4.00 A.
15.

2/19/91
19213-B


THIS CORRECTION ADDED
DIMENSIONS AND CURVE
DATA TO -021 BELOW

REF. DV. 1416/189

$\Delta = 65-31-51$
 $R = 1135.16$
 $A = 1106.16$
 $Ch = 1105.70$

#19213
-001
117.50 A.

II

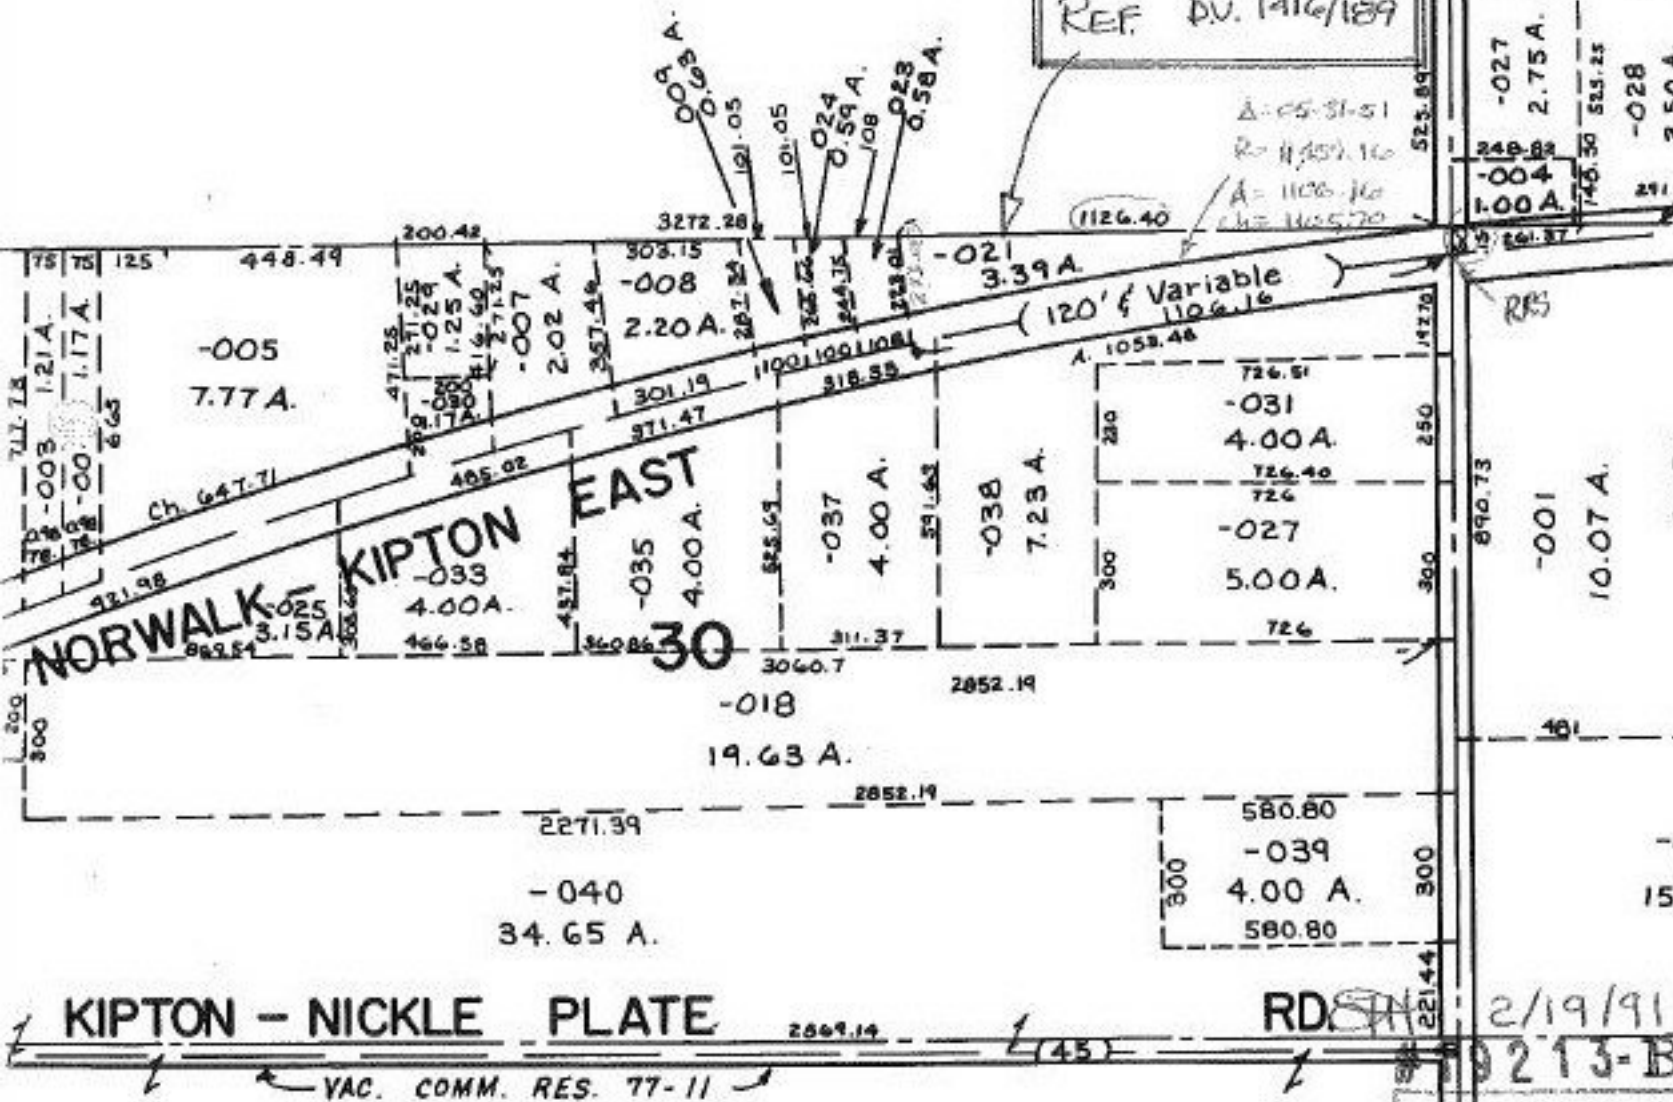

DEED CHECK
ADDS DIMENSIONS

APPROVED
L. RAIN CO.
P. DEPT.
DATE 12-18-90
PAGE 14-A
BY T. M. Man
VOL 19213-B