

1246.55

270

64.89

(-022) (-02A) # 4729  
 PARCEL 1 & PARCEL 2 WERE COMBINED  
 6/20/70 TO CREATE -02B FRONTAGE IS  
 NOW ~~8120/70~~ 170' & DECREASE  
 IS 0.99 A.  
 REFERENCE DV. 973/180

~~REOMB.~~

~~8120/70~~

CHECK  
CORR.

0.13  
 .86  
 ---  
 99A


-034  
 13.13 A.

[REDACTED]  
 [REDACTED]

PARCEL. DV. 973/180

DEED  
FRONTAGE

138.14  
 20.00  
 ---  
 158.14  
 pt. of 02B 20.00  
 pt. of 02A 150.00  
 Frontage 170.00

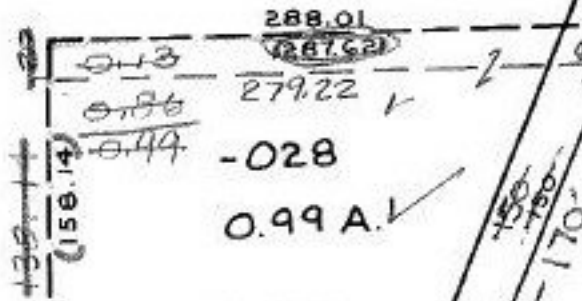

SEE 10-00-003-FA

11/7/91  
 #19215B

APPROVED  
 LORAIN CO.  
 MAP DEPT.  
 DATE 12-6-90  
 PAGE 10-00-003-E  
 BY Carolyn Francis  
 VOID AFTER #19215-B

1020.37

220.78

181.37

139.04

596.01

-029  
 1.35 A.

101.63