


05-00-018-101- PRIOR INST. O.R.167/103
 SURVEYED BY: MICHAEL G. HURA REG. SURVEYOR
 C-1: INF

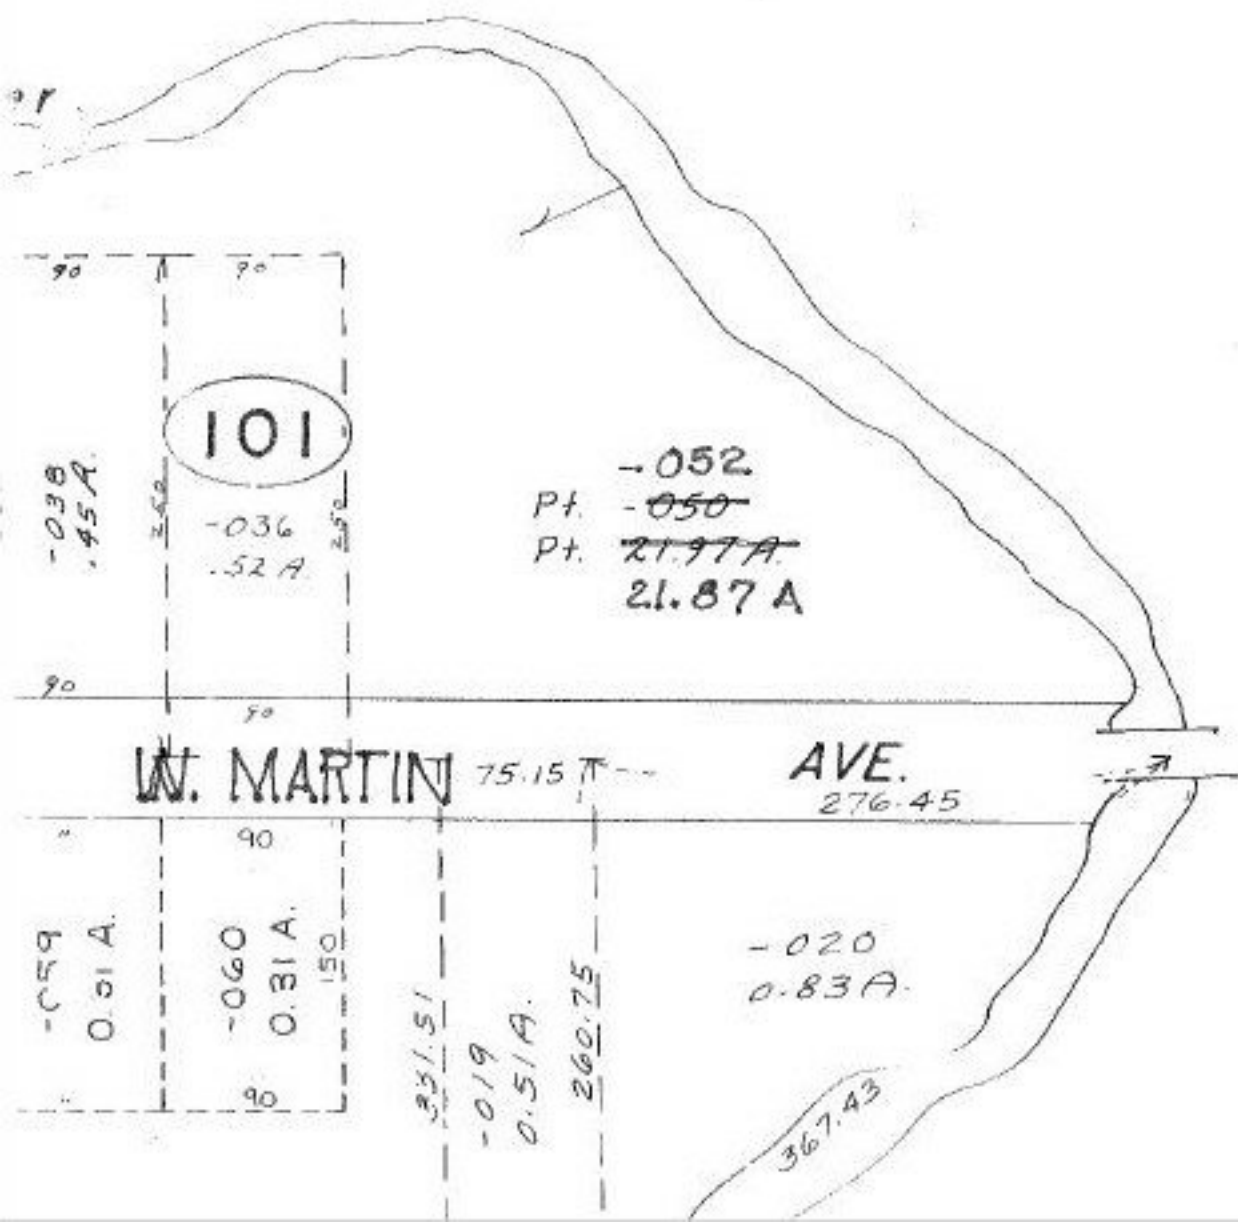

2/13/91
 #19215

APPROVED
 LORAIN CO.
 MAP DEPT.

DATE 12-10-90

PAGE 5-00-018-A

CAROLYN
 BY FRANCIS

VOID AFTER #19215