


SEE 4-1

ACREAGE  
CORRECTION

4/23/91  
# 19216-B

APPROVED LORAIN CO. MAP DEPT.	
DATE 11/30/90	PAGE 4-00-001-B
BY T. MOULS	
VOID METER	19216-B

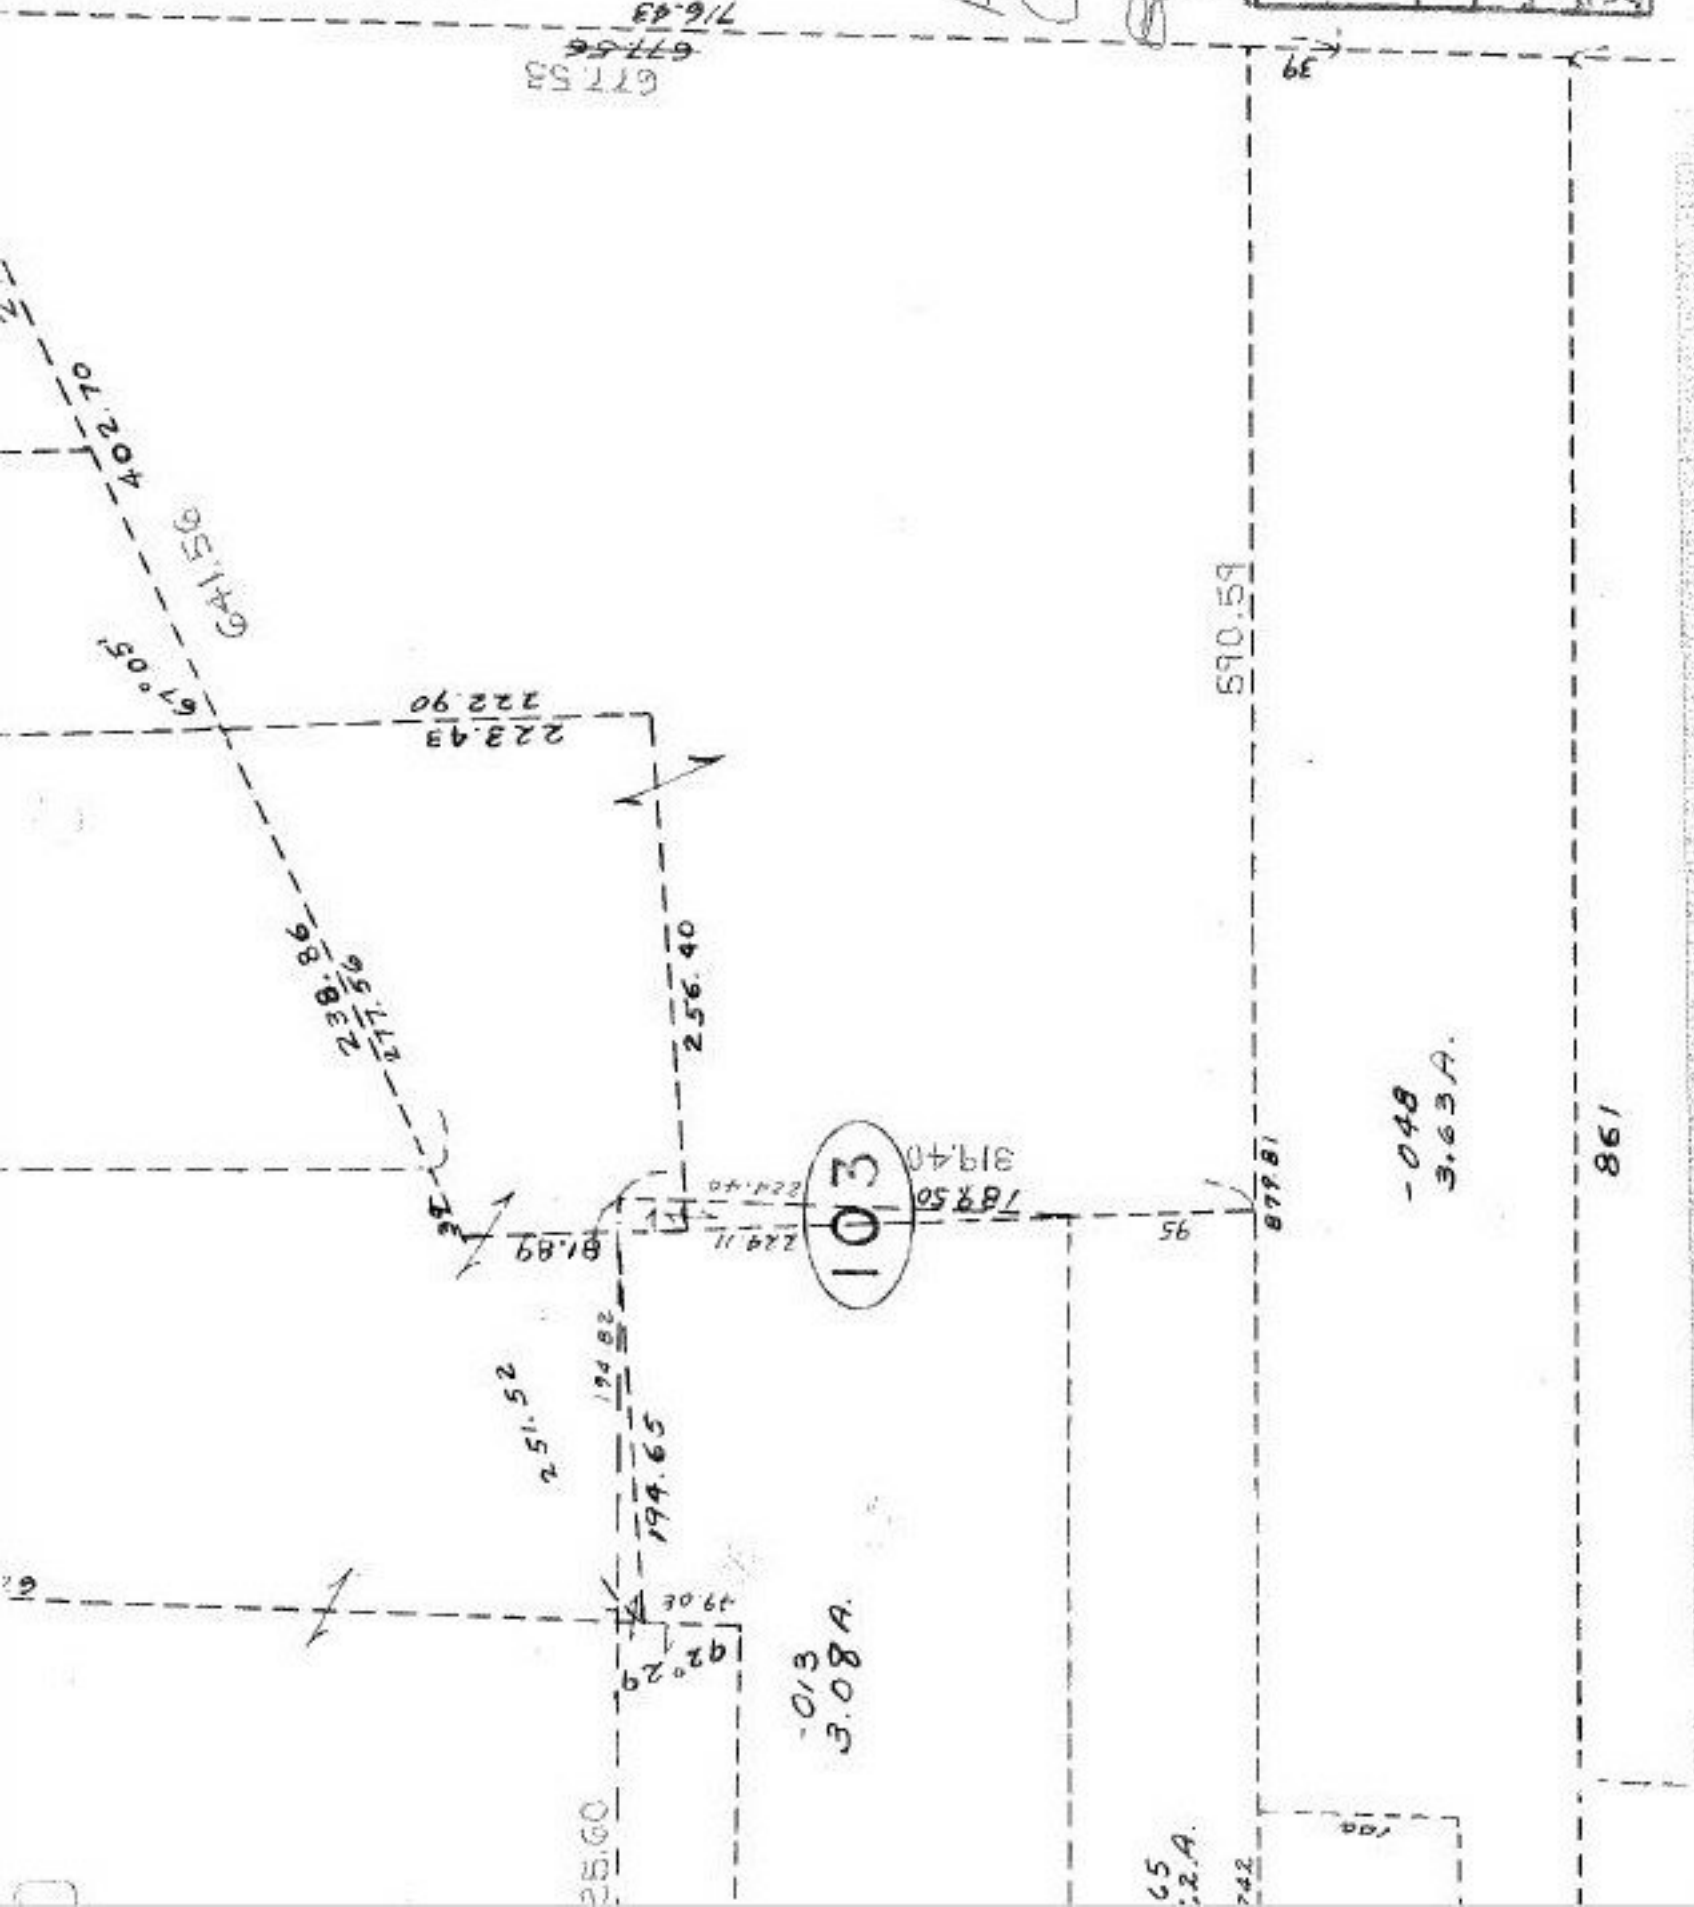

677.53  
677.56  
716.43

67°00'5"  
641.56  
402.70

222.90  
223.43

238.86  
217.56

256.40

103

189.50  
319.40

251.52

194.82

194.65

190.05

013  
3.08 A.

25.60

65  
2.2 A.

590.59

879.81

-048  
3.63 A.

861