


MEDINA - NORWALK

18

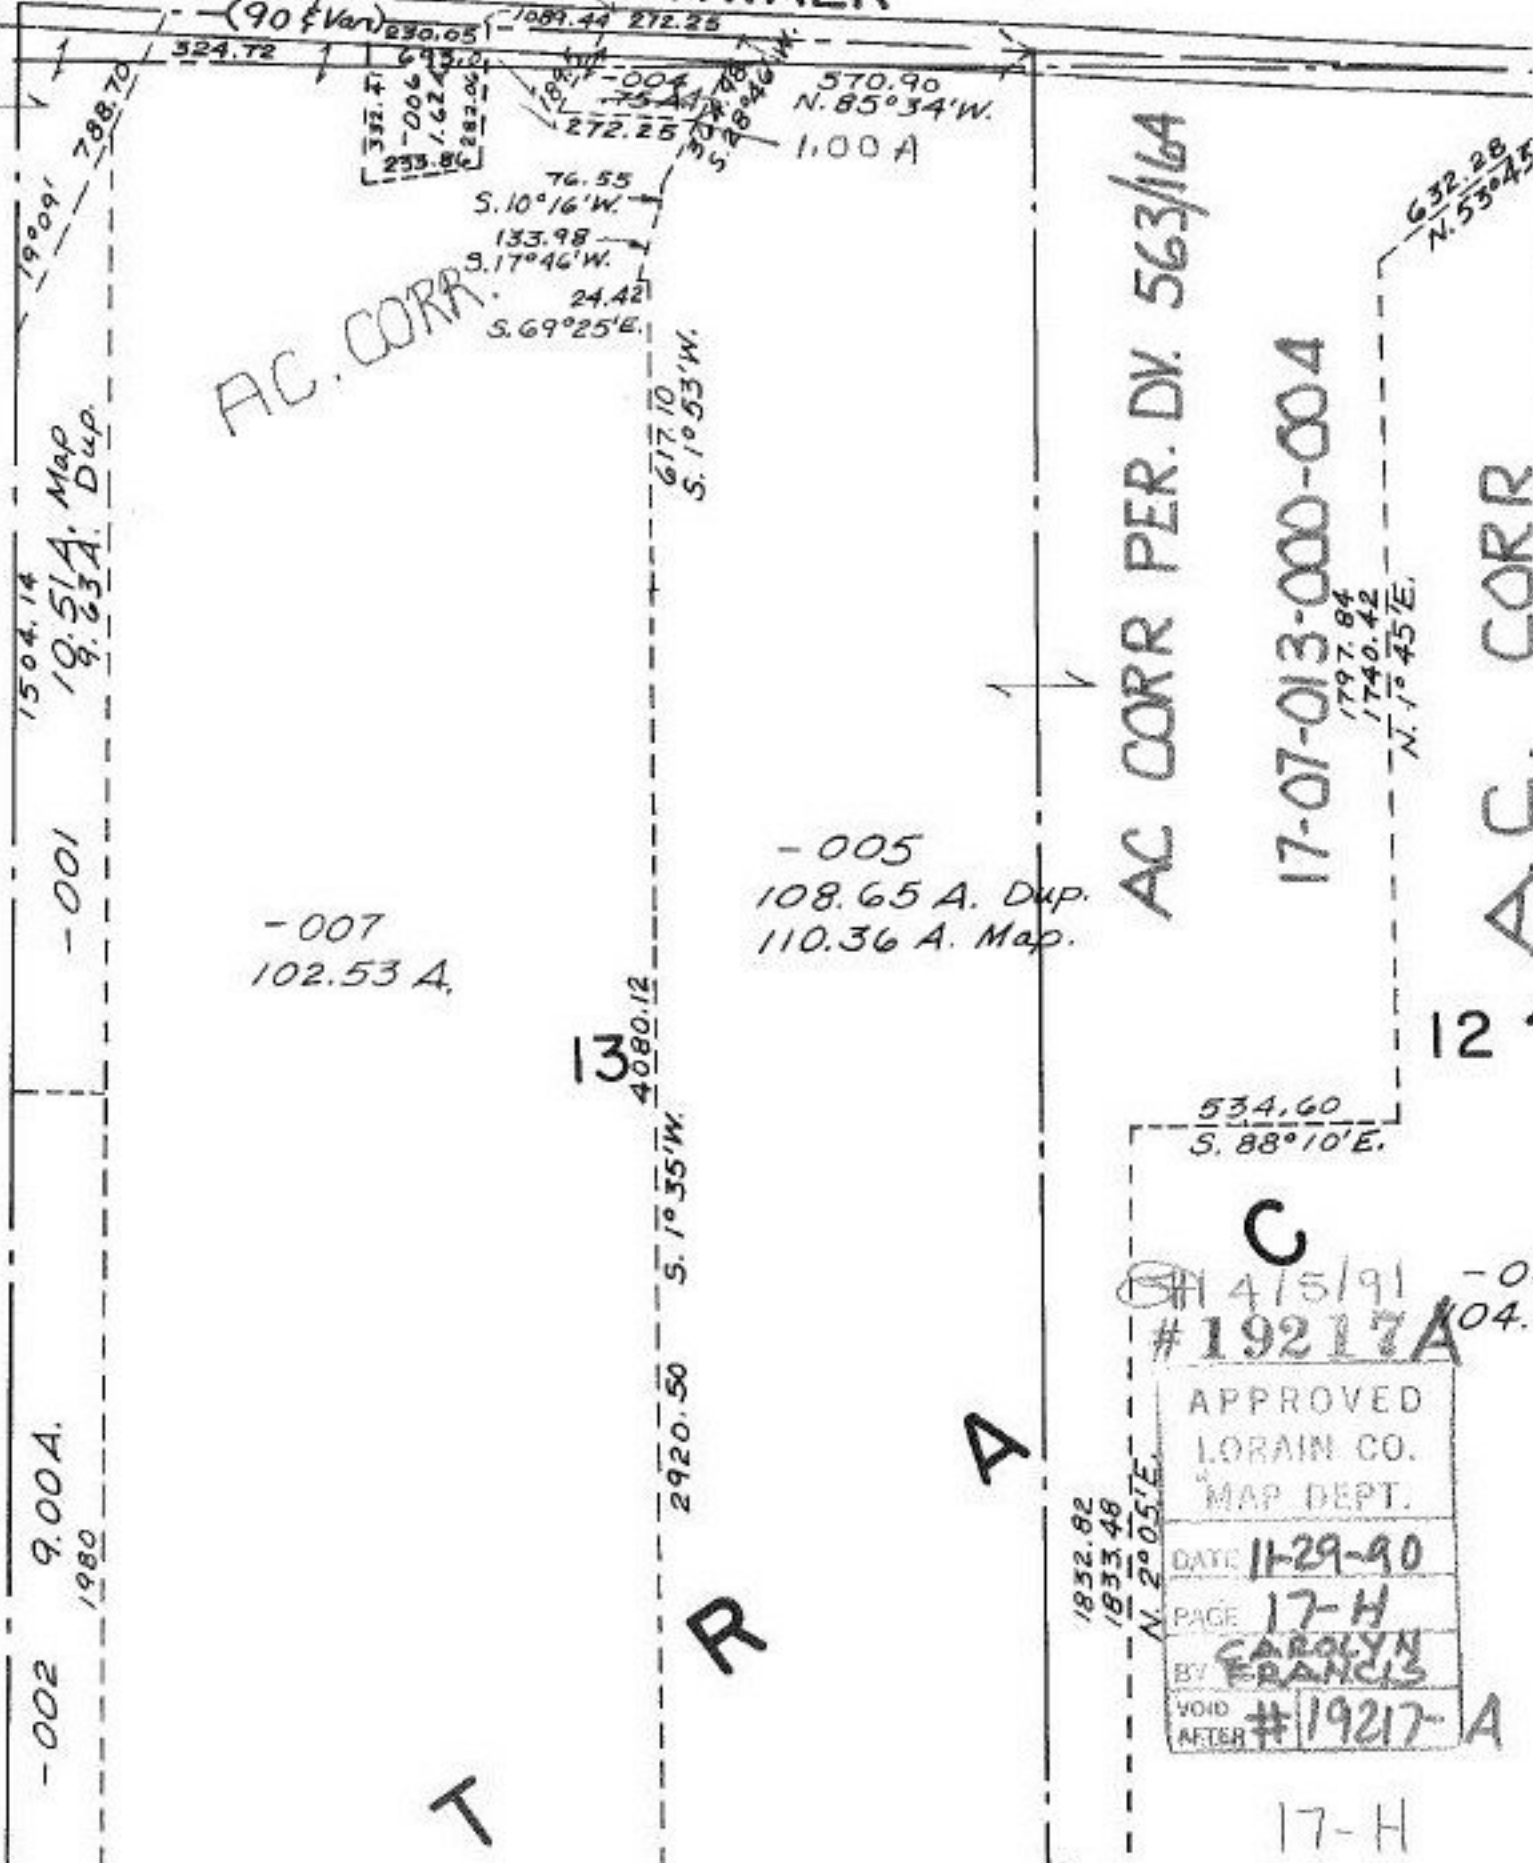

AC CORR PER. DV. 563/164

17-07-013-000-004

APPROVED
LORAIN CO.
MAP DEPT.
DATE 11-29-90
PAGE 17-H
BY CAROLYN FRANCIS
VOID AFTER #19217-A