


DETAIL
NOT TO SCALE

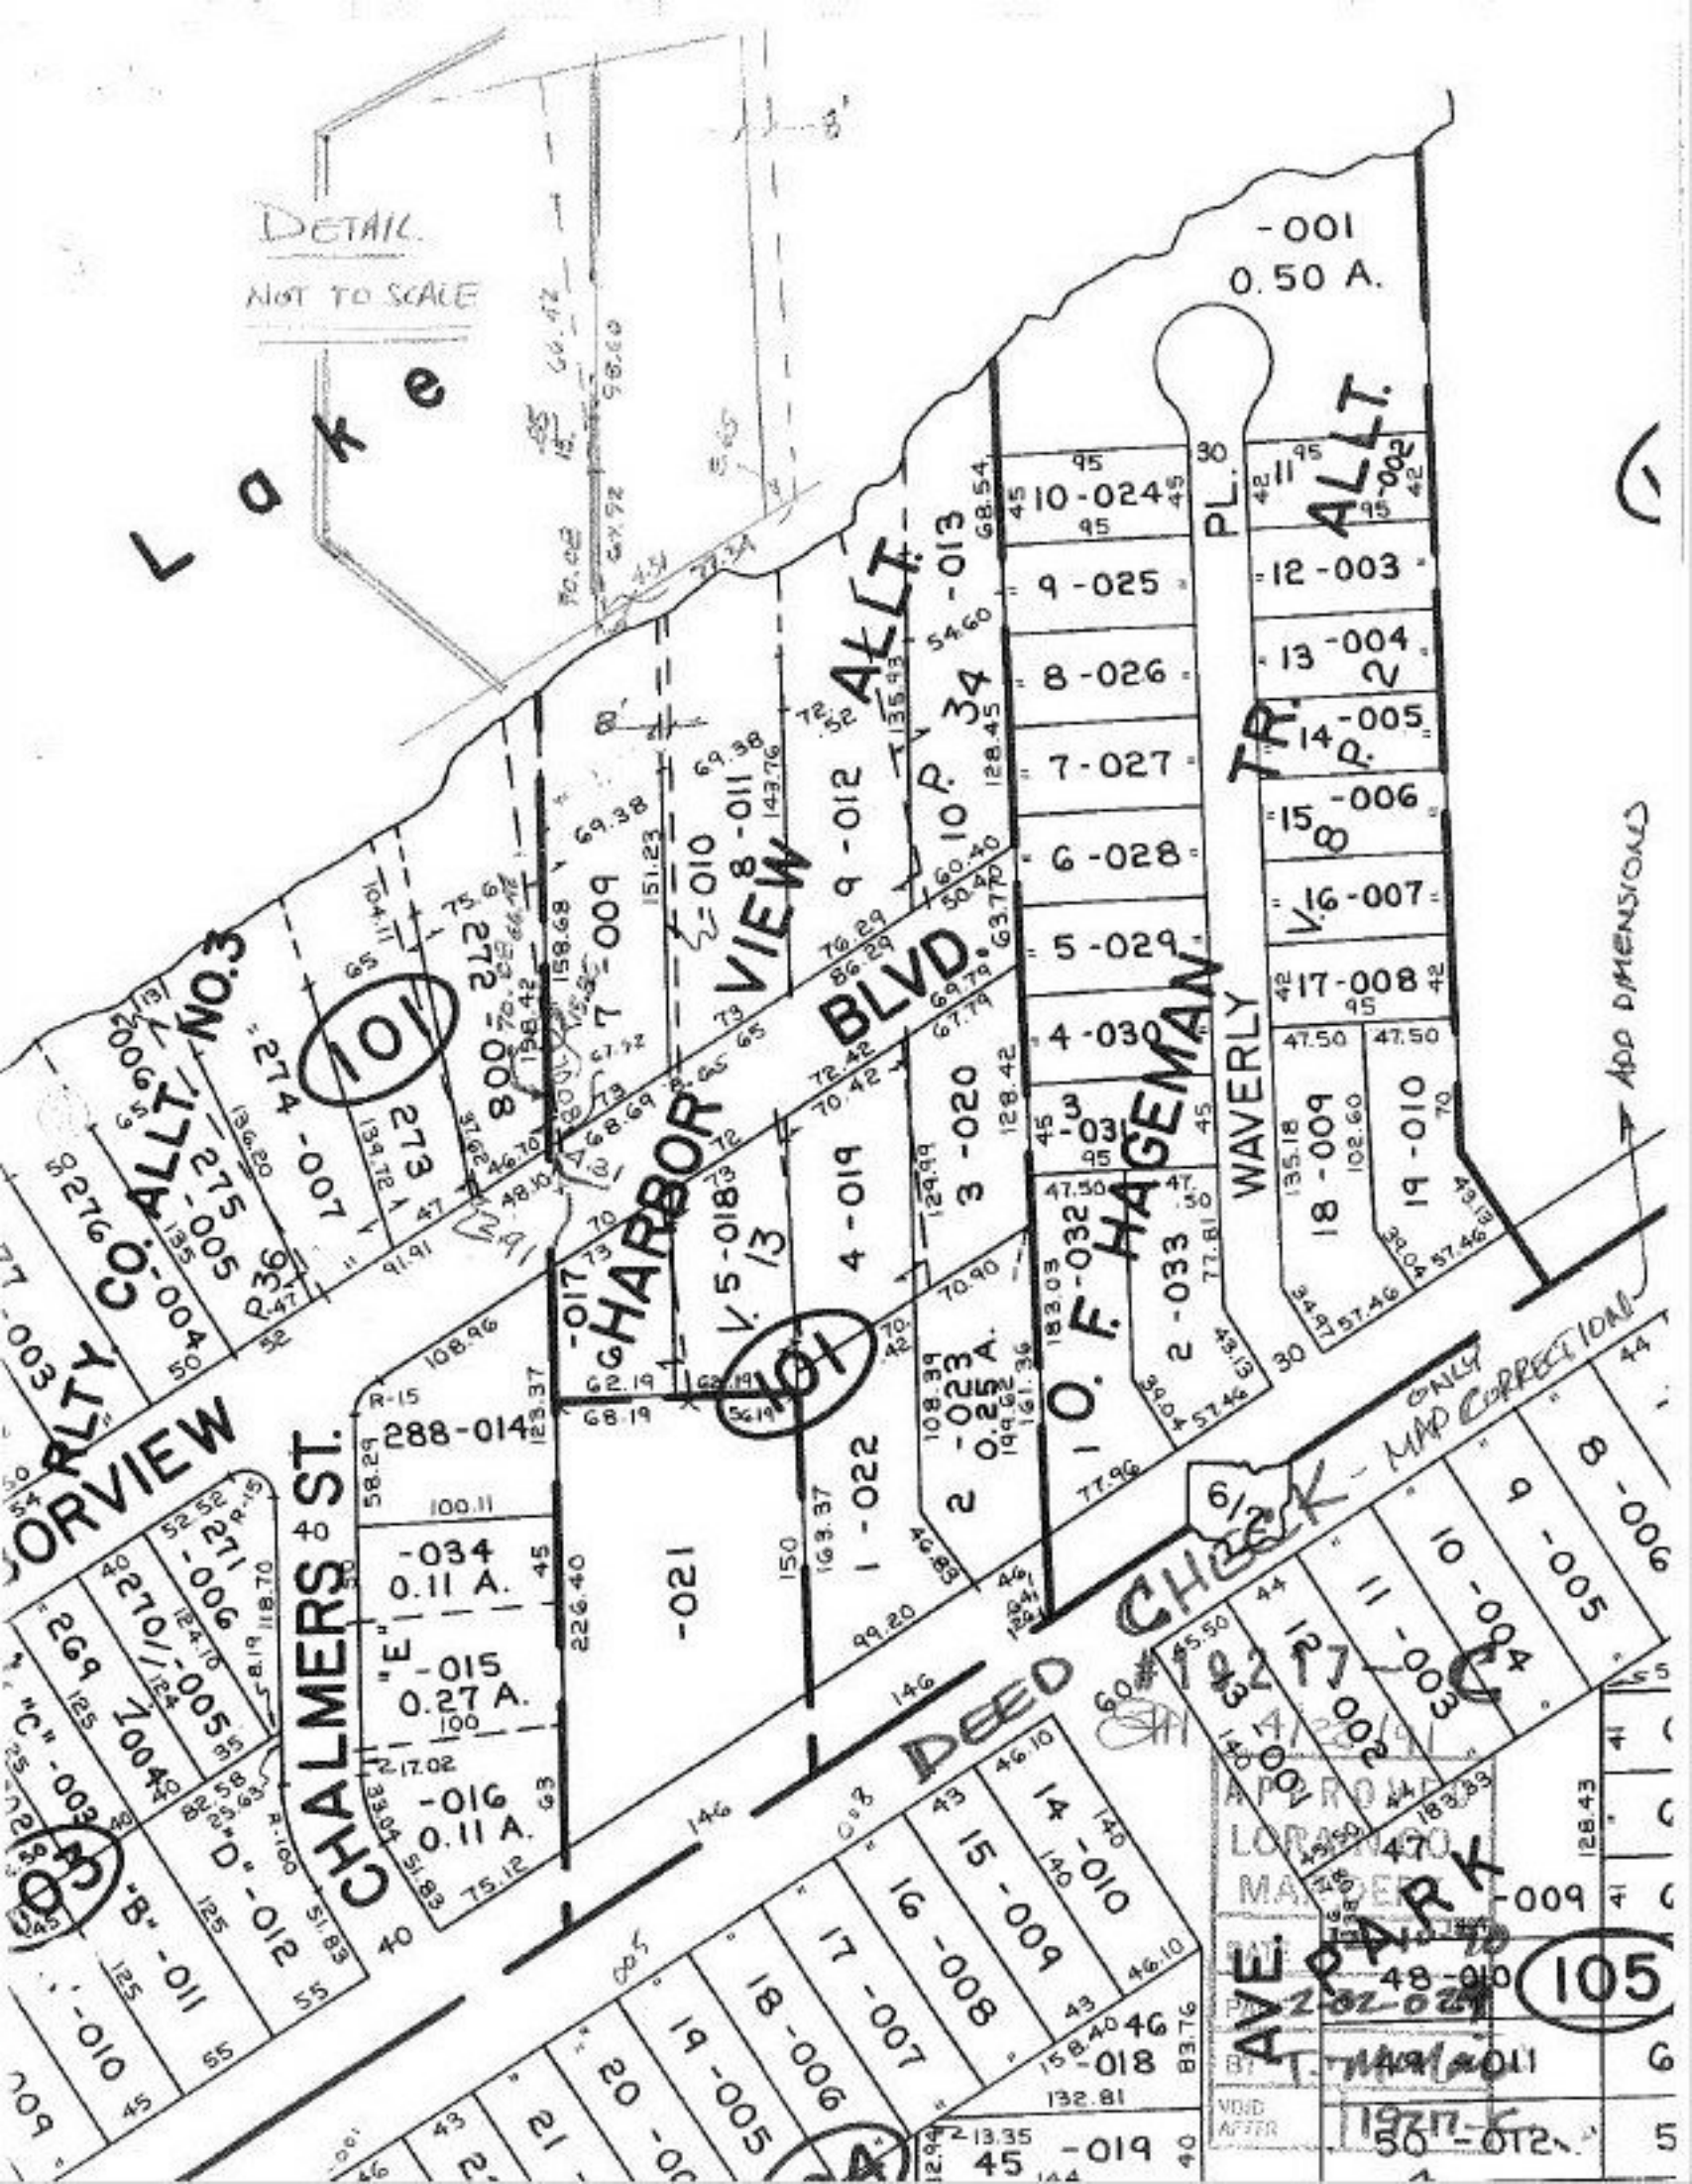

-001
0.50 A.

ALLT.

ALLT.

BLVD.

HAGEMAN

WAVERLY

CHALMERS ST.

ORVIEW

ALTY CO. ALT. NO. 3

ADD DIMENSIONS

DEED CHECK - ONLY MAP CORRECT

AVE. PARK

105

VOID AFTER

1977-6

5