


TURNPIKE

V.R.D.

OBERLIN

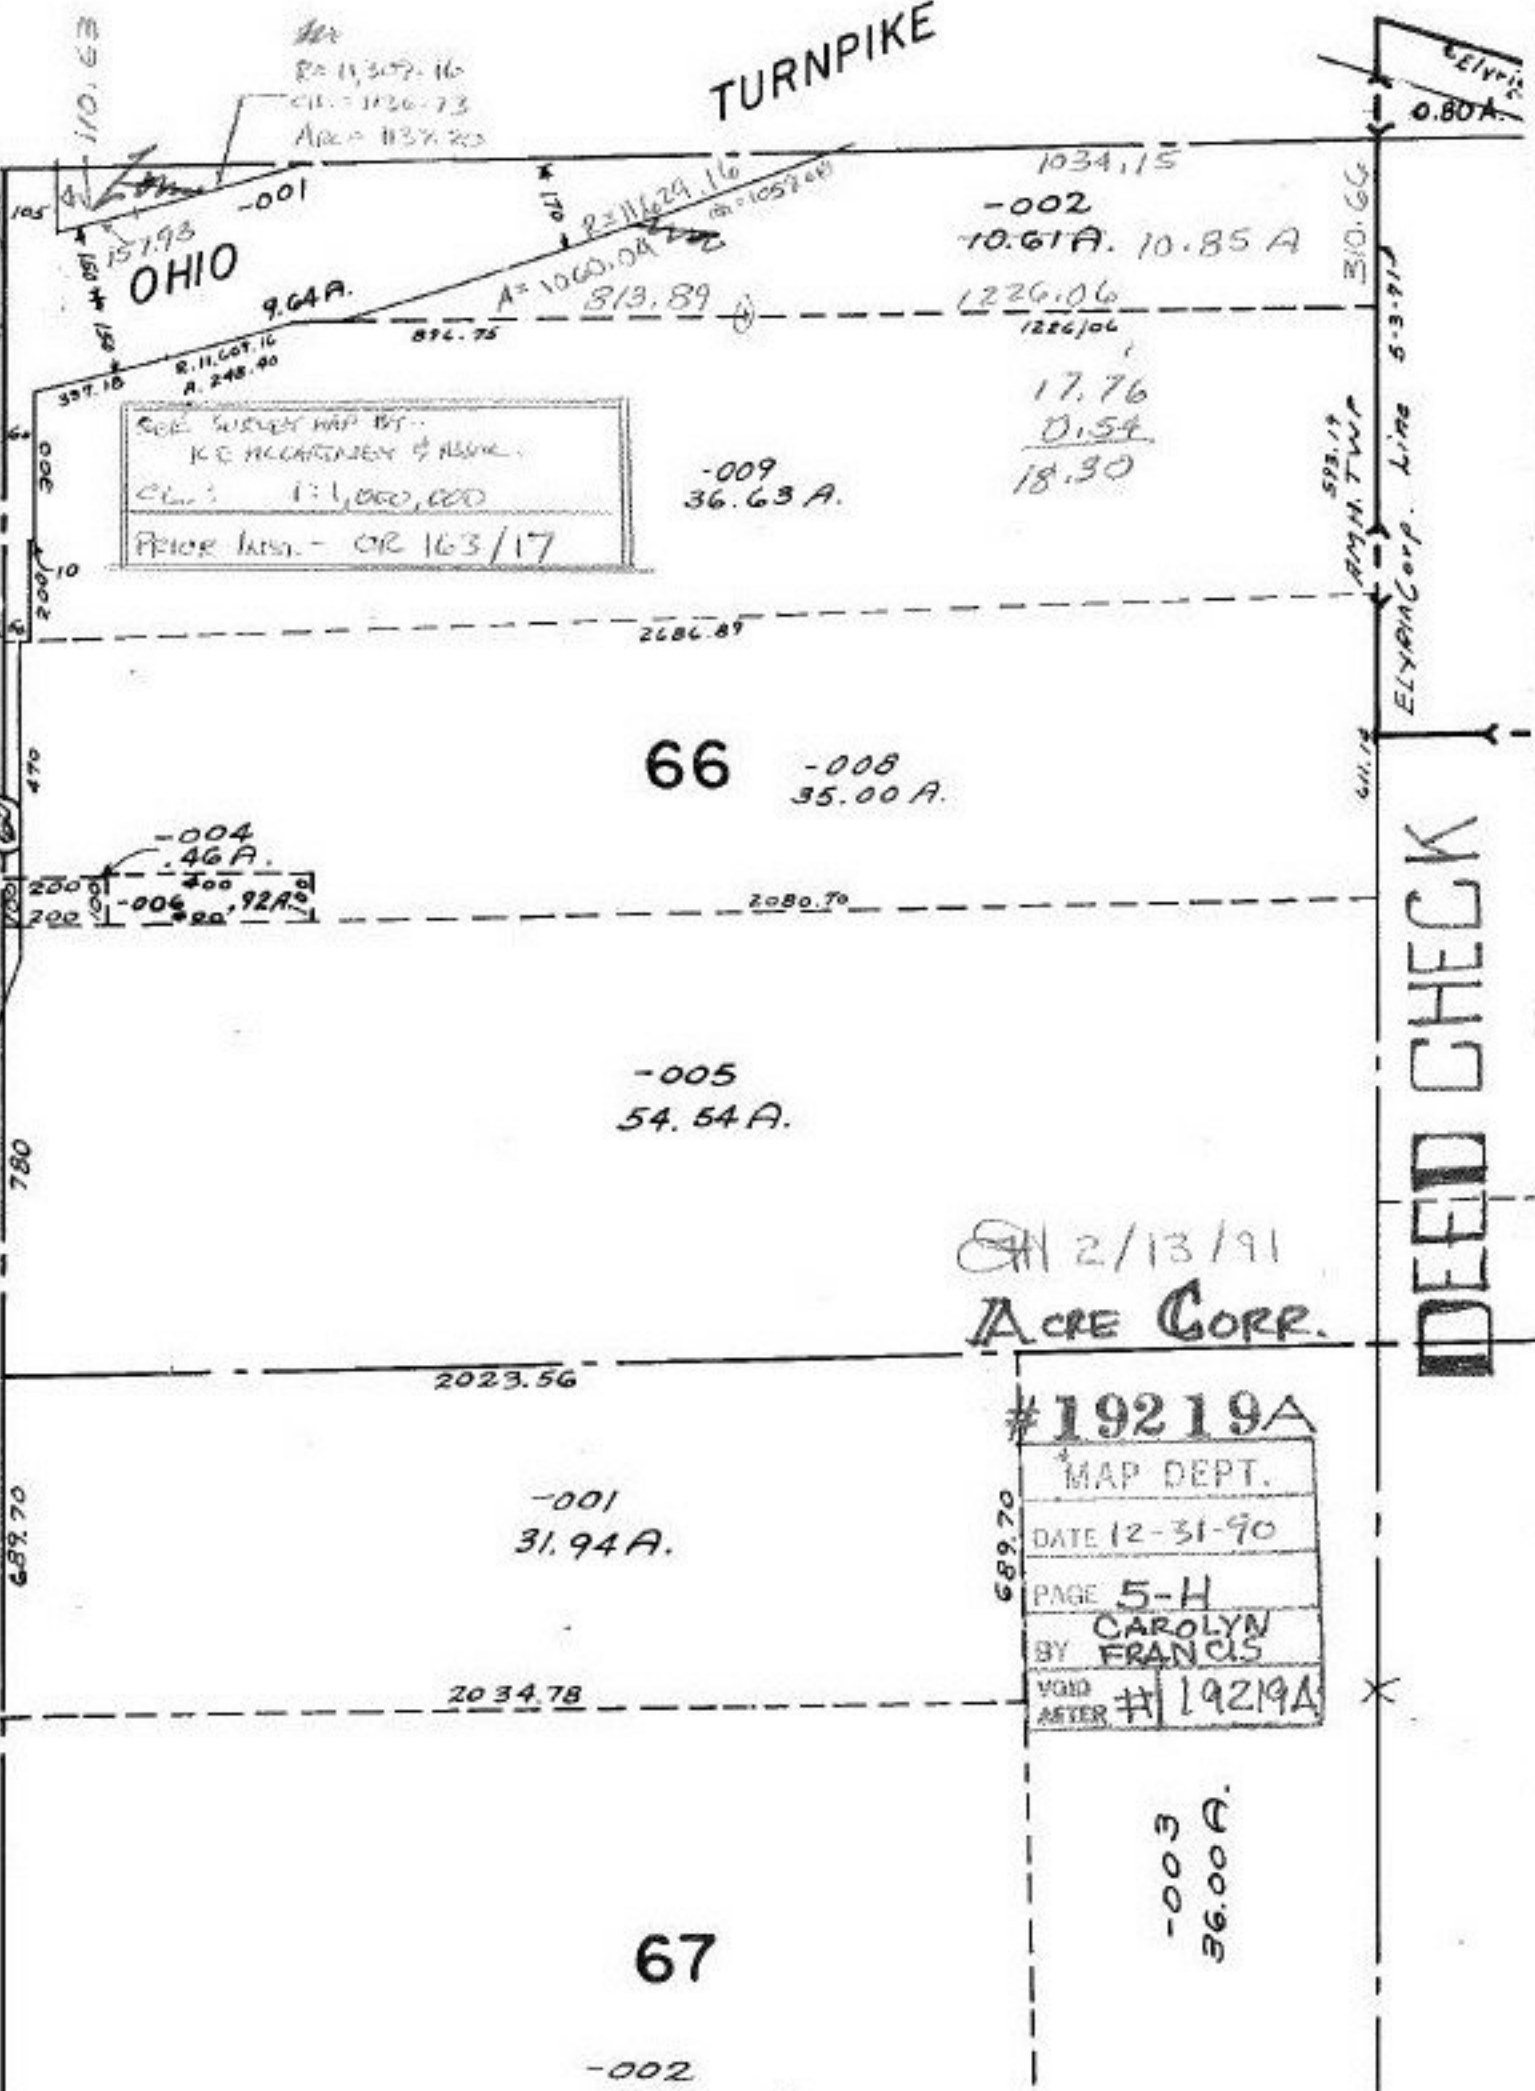

DEED CHECK

2/13/91
ACRE CORR.

#19219A

MAP DEPT.
DATE 12-31-90
PAGE 5-H
BY CAROLYN FRANCIS
VOID AFTER #19219A

67

-002