


#1922

SEE 3 H

#1922  
 APPROVED  
 LORAIN CO.  
 MAP DEPT.  
 DATE 7-8-68  
 4 A  
 BY LWHall

~~-003~~ -056  
 78.85 A. 78.54 A.C

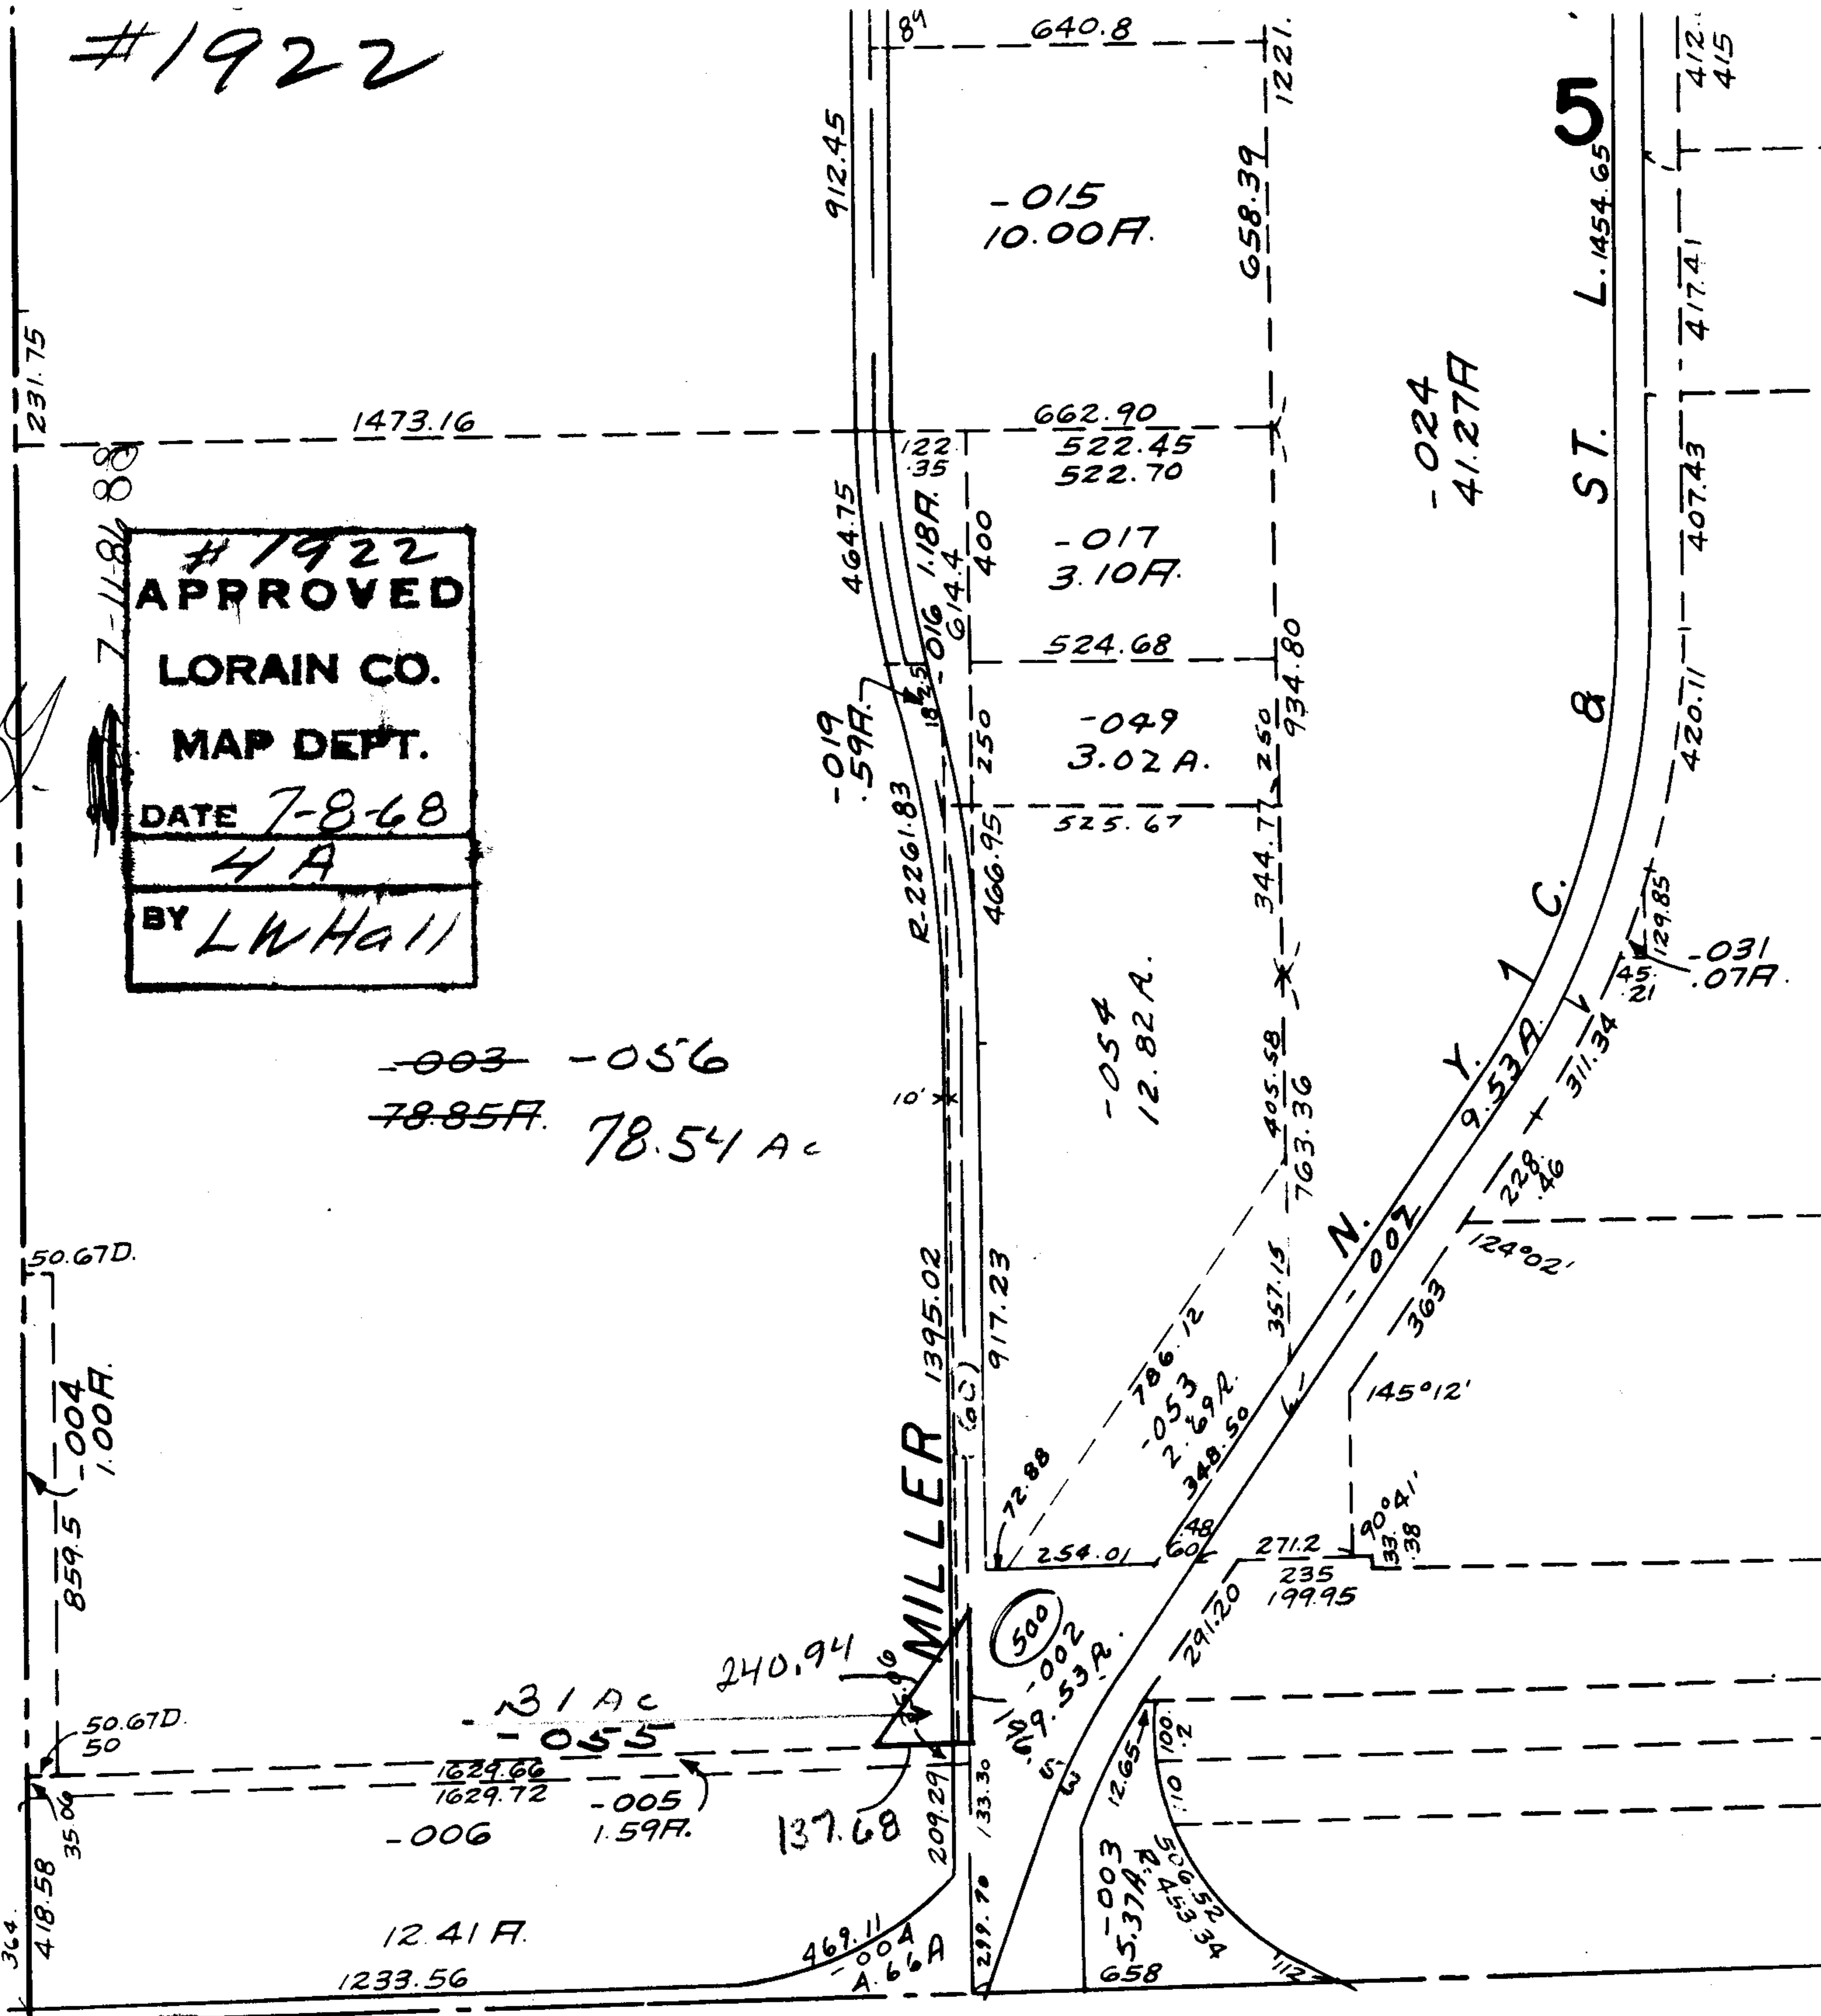

Done 7/23/68  
 Jim Lease

SEE 4-E

# AVON LAKE VILLAGE

SCALE: 1" = 400'

4 A