

HUGHES

27.00 A.

2657.78

PARCEL IS BEING

MOVED DOWN

PARCEL WAS DRAWN IN

-003 WRONG PLACE

114.23 A. # SPLIT

#12702

51

-001

52.50 A.


ERS

ERS

RD 806.87

RD

QUARRY

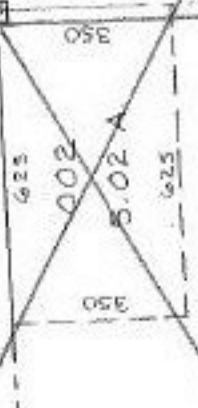

THIS IS TO CORR SPLIT #12702 MAP

3288.72

-001

31.70 A.

1089

-003

8.80 A.

1089

SA 2/19/91
#19241A

APPROVED -002

LORAIN CO.

MAP DEPT.

40.00 A.

70

DATE 1-16-91

PAGE 14-A

BY CAROLYN FRANCIS

VOID AFTER #19241A

14-00-051-000-002 MAP CORR

-004

40.00 A.

-012

8.78 A

1360.18

-011

18.53

-009

7.80 A

13.50

-007

1.01 A.

-002

11.00 A

407.88

1570.8