


NOT TO  
DETAIL SCALE

OBERLIN RD.

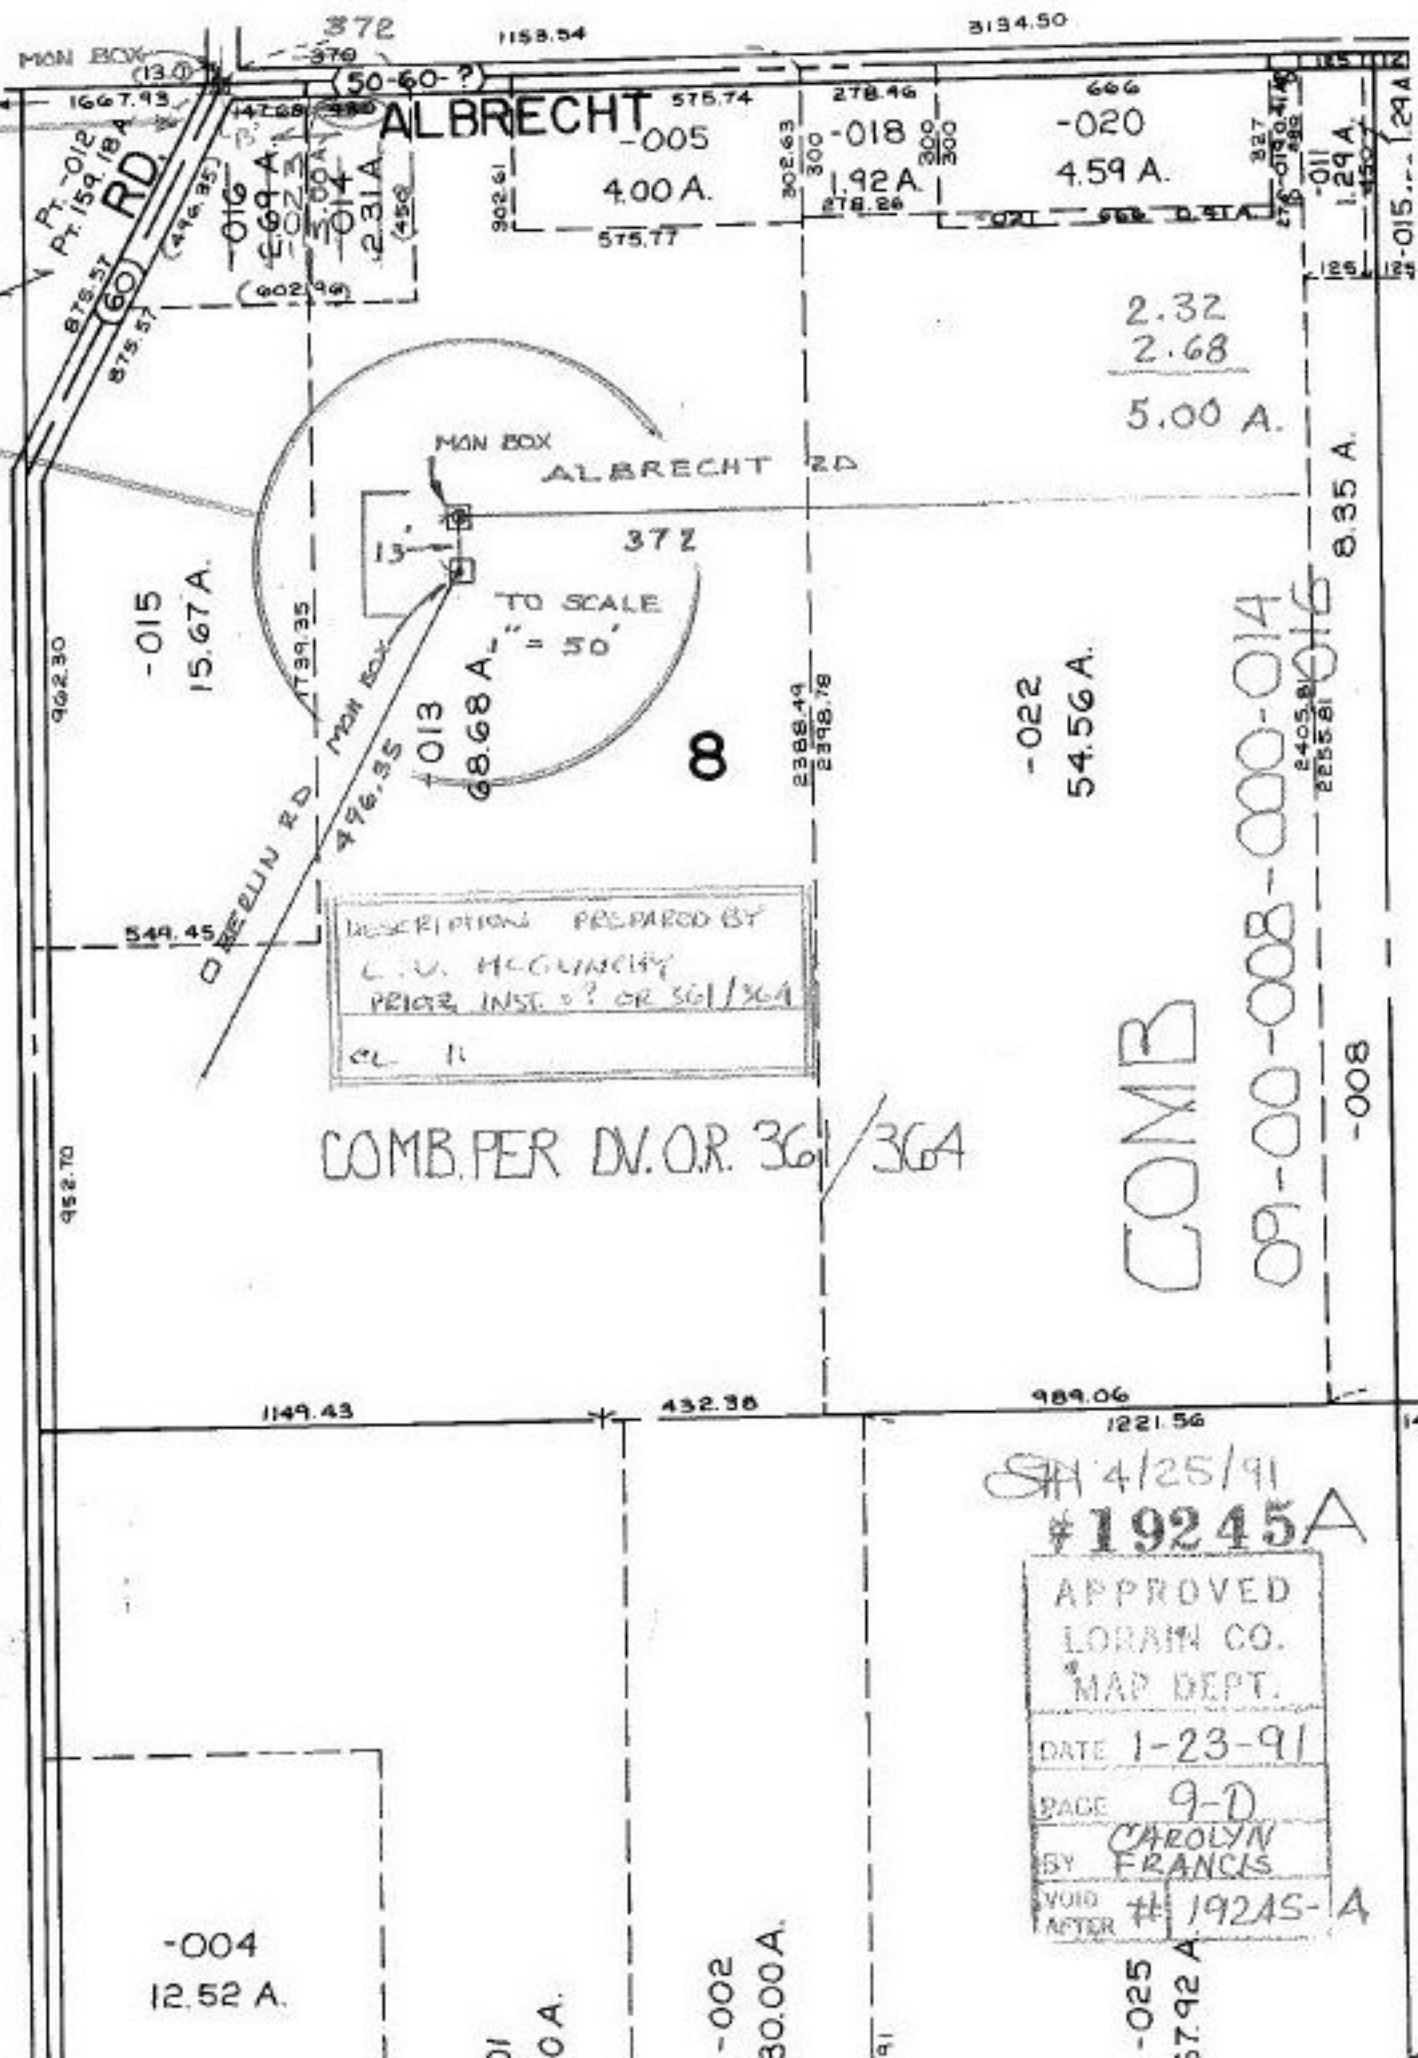

DESCRIPTION PREPARED BY  
 L. V. MCCUNEY  
 PRICE INST. 0? OR 361/364  
 PL. 11

COMB. PER DV. OR. 361/364

COMB

09-00-008-000-014  
 2405.81  
 2855.81

4/25/91  
 #19245A

APPROVED  
 LORAIN CO.  
 MAP DEPT.  
 DATE 1-23-91  
 PAGE 9-D  
 BY CAROLYN  
 FRANCIS  
 VOID AFTER # 19245-A

-004  
 12.52 A.

01  
 00 A.

-002  
 30.00 A.

91

-025  
 27.92 A

V