


SEE 4-00-0

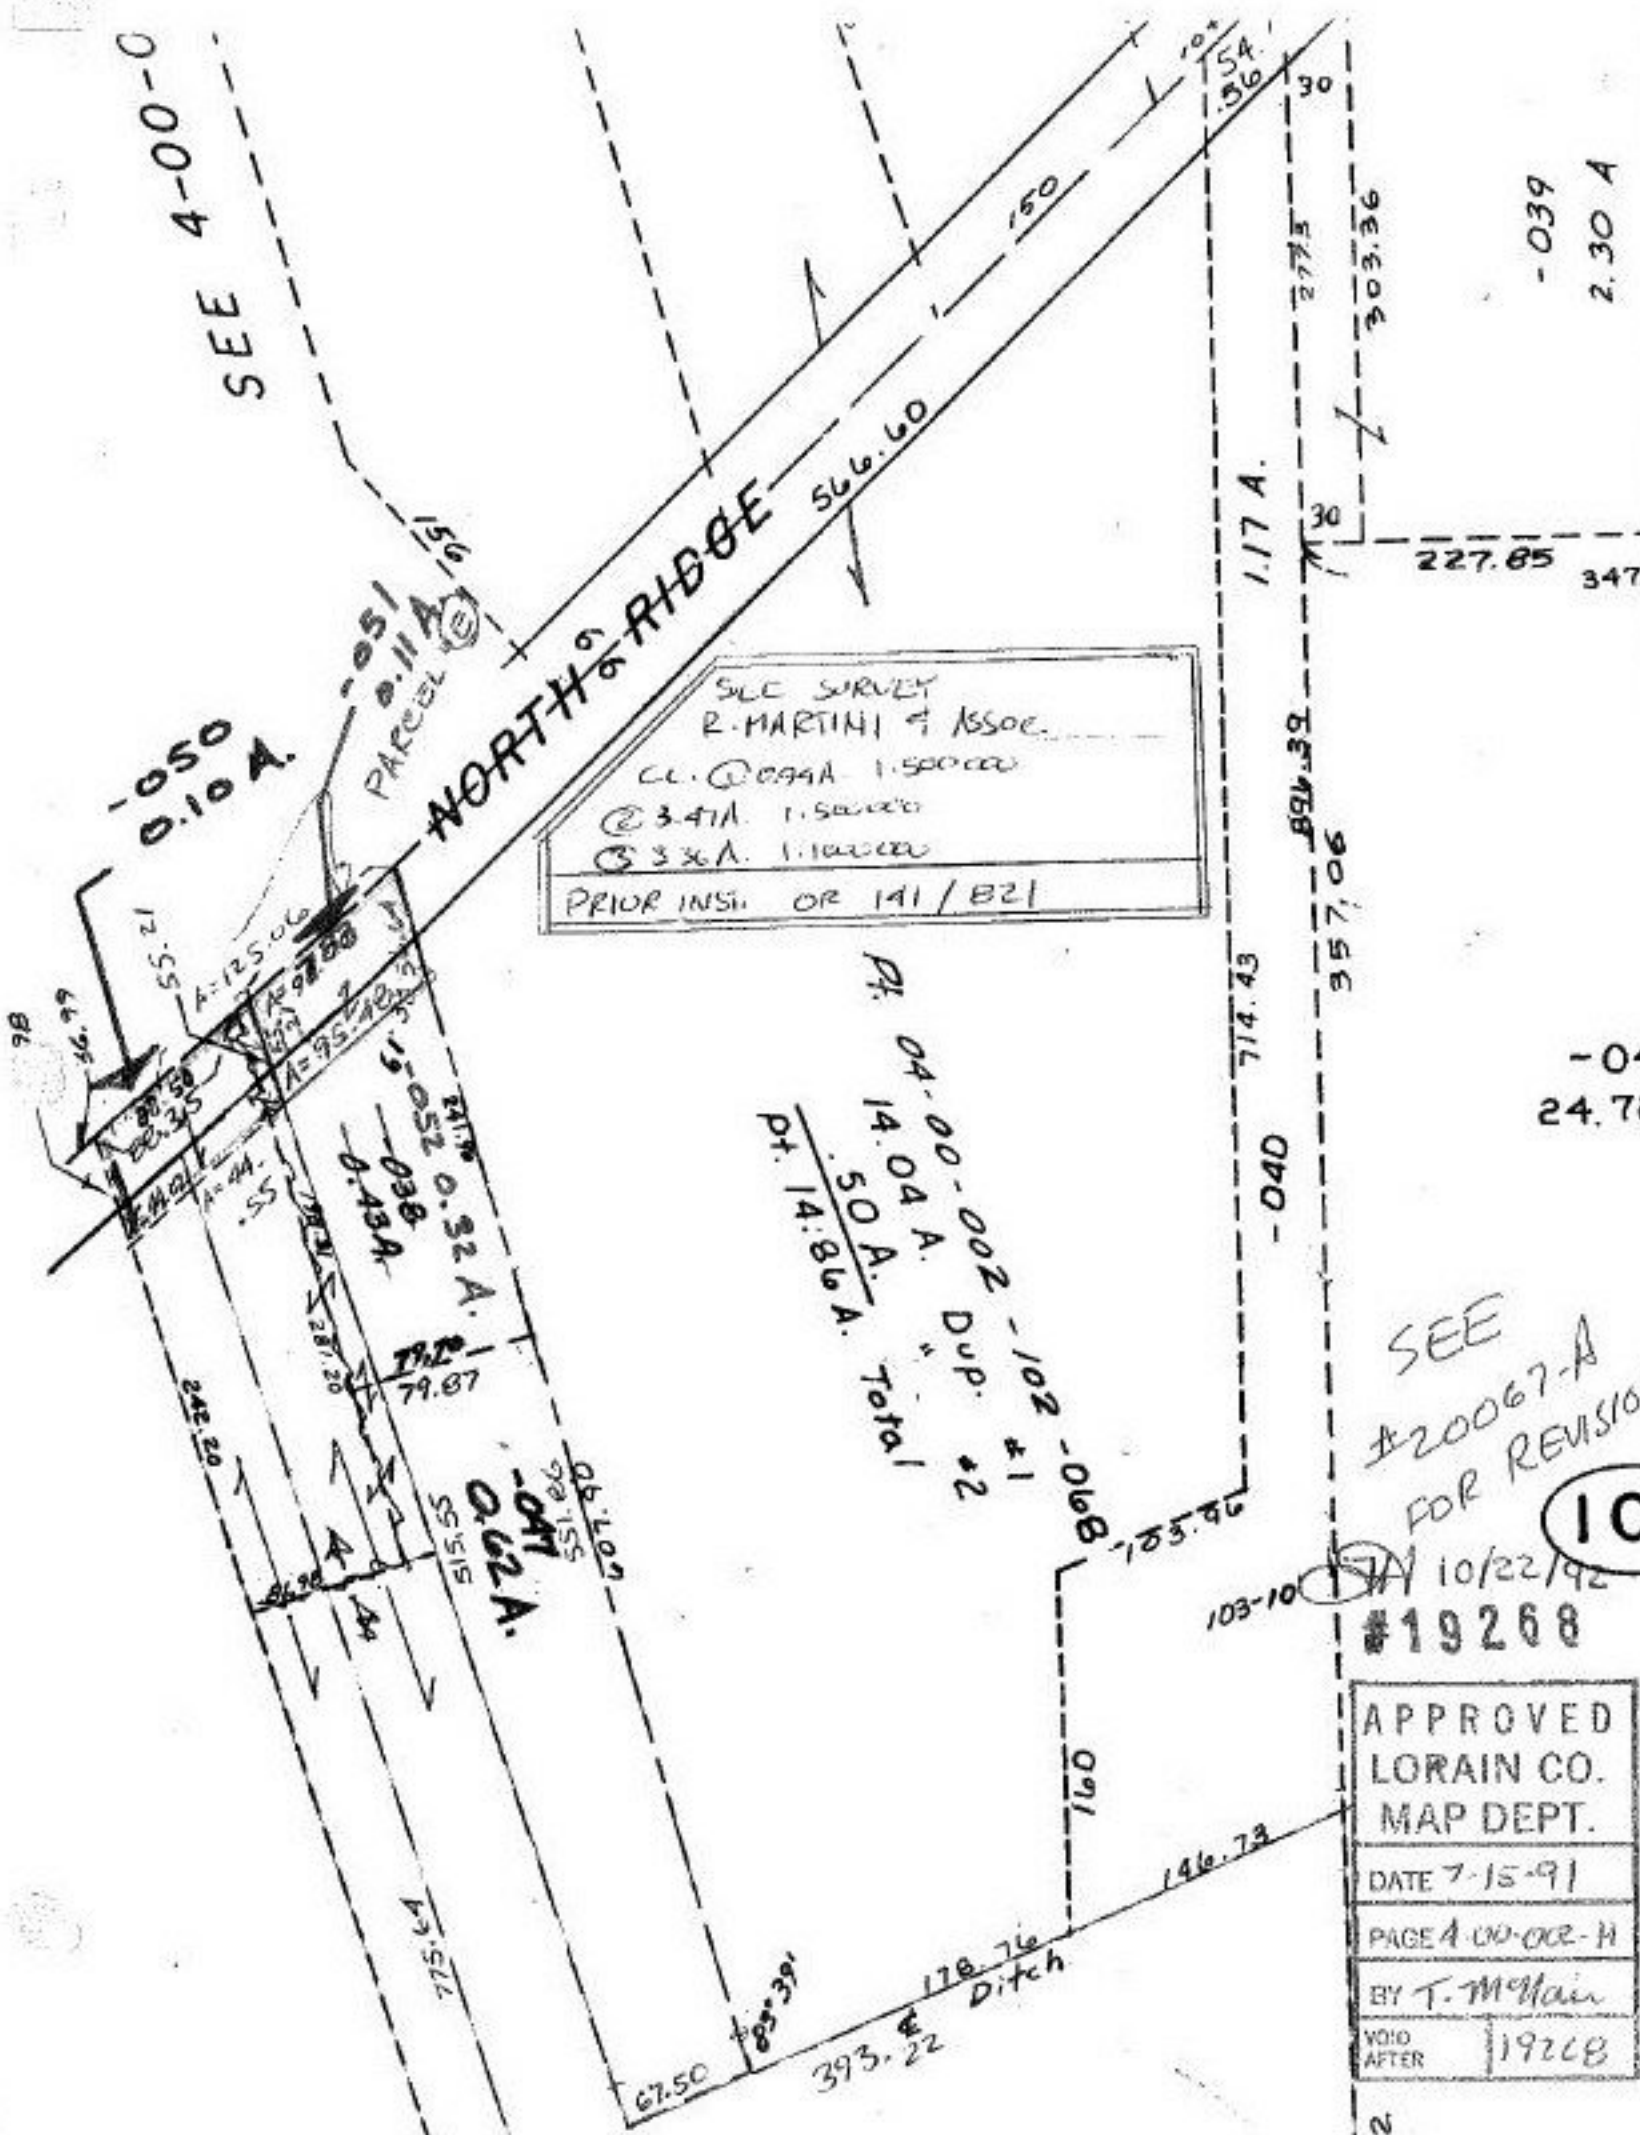

-039
2.30 A

-04
24.7E

SEE #20067-A FOR REVISION

10

10/22/92
#19268

APPROVED LORAIN CO. MAP DEPT.	
DATE 7-15-91	
PAGE 4 00-00-H	
BY T. McMain	
VOID AFTER	19268

N