


0.87 A
 0.52 A
~~0.35 A~~
 0.26 A

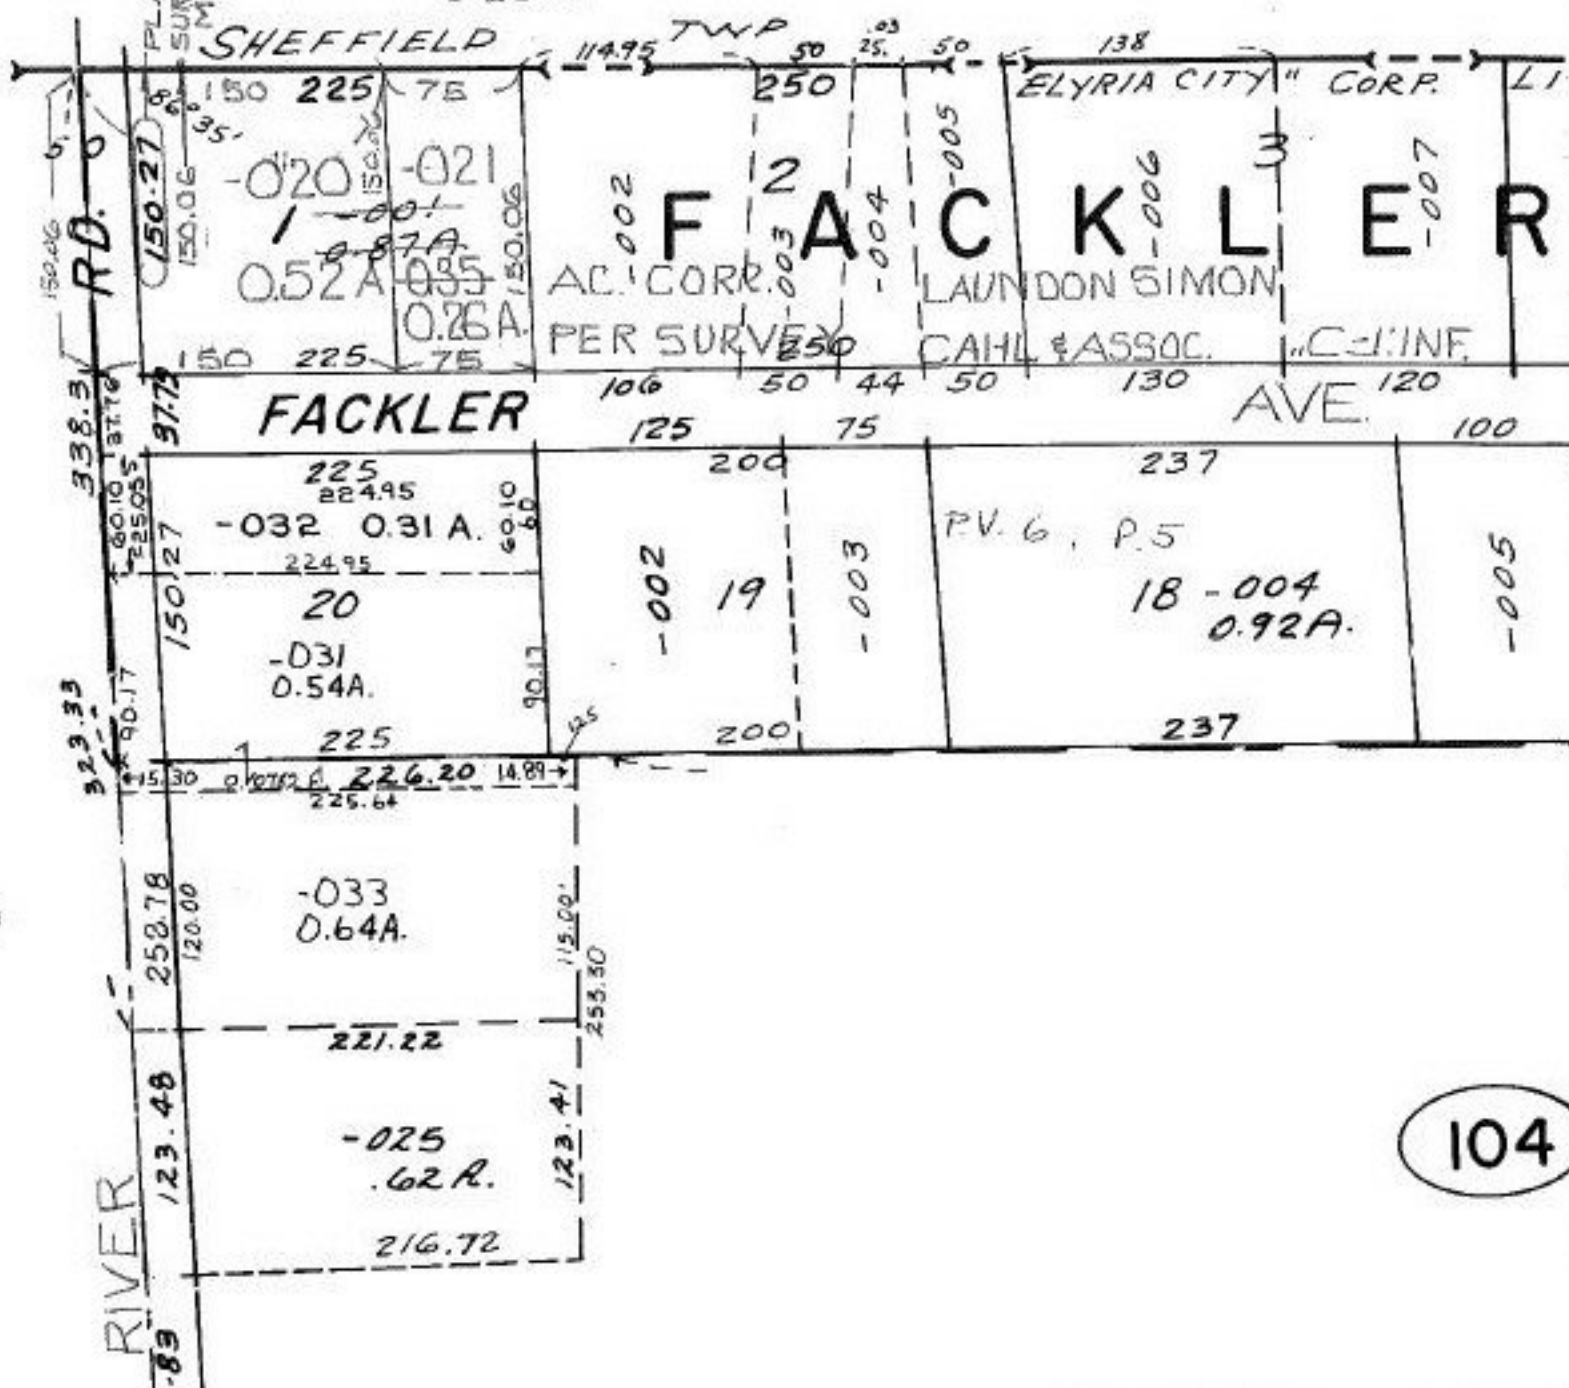

104

06-22-012-101- PRIOR INST. 1335/121
 SURVEY BY: LAUNDON. SIMON. CAHL
 & ASSOC. C=1: INF.

#19282
 APPROVED
 LORAIN CO.
 MAP DEPT.
 DATE 2-15-91
 PAGE 6-11
 BY CAROLYN
 FRANCIS
 VOTO
 MEYER # 19282

-030
 6.66 A.

-010

1.26 A.