


SQUIRE

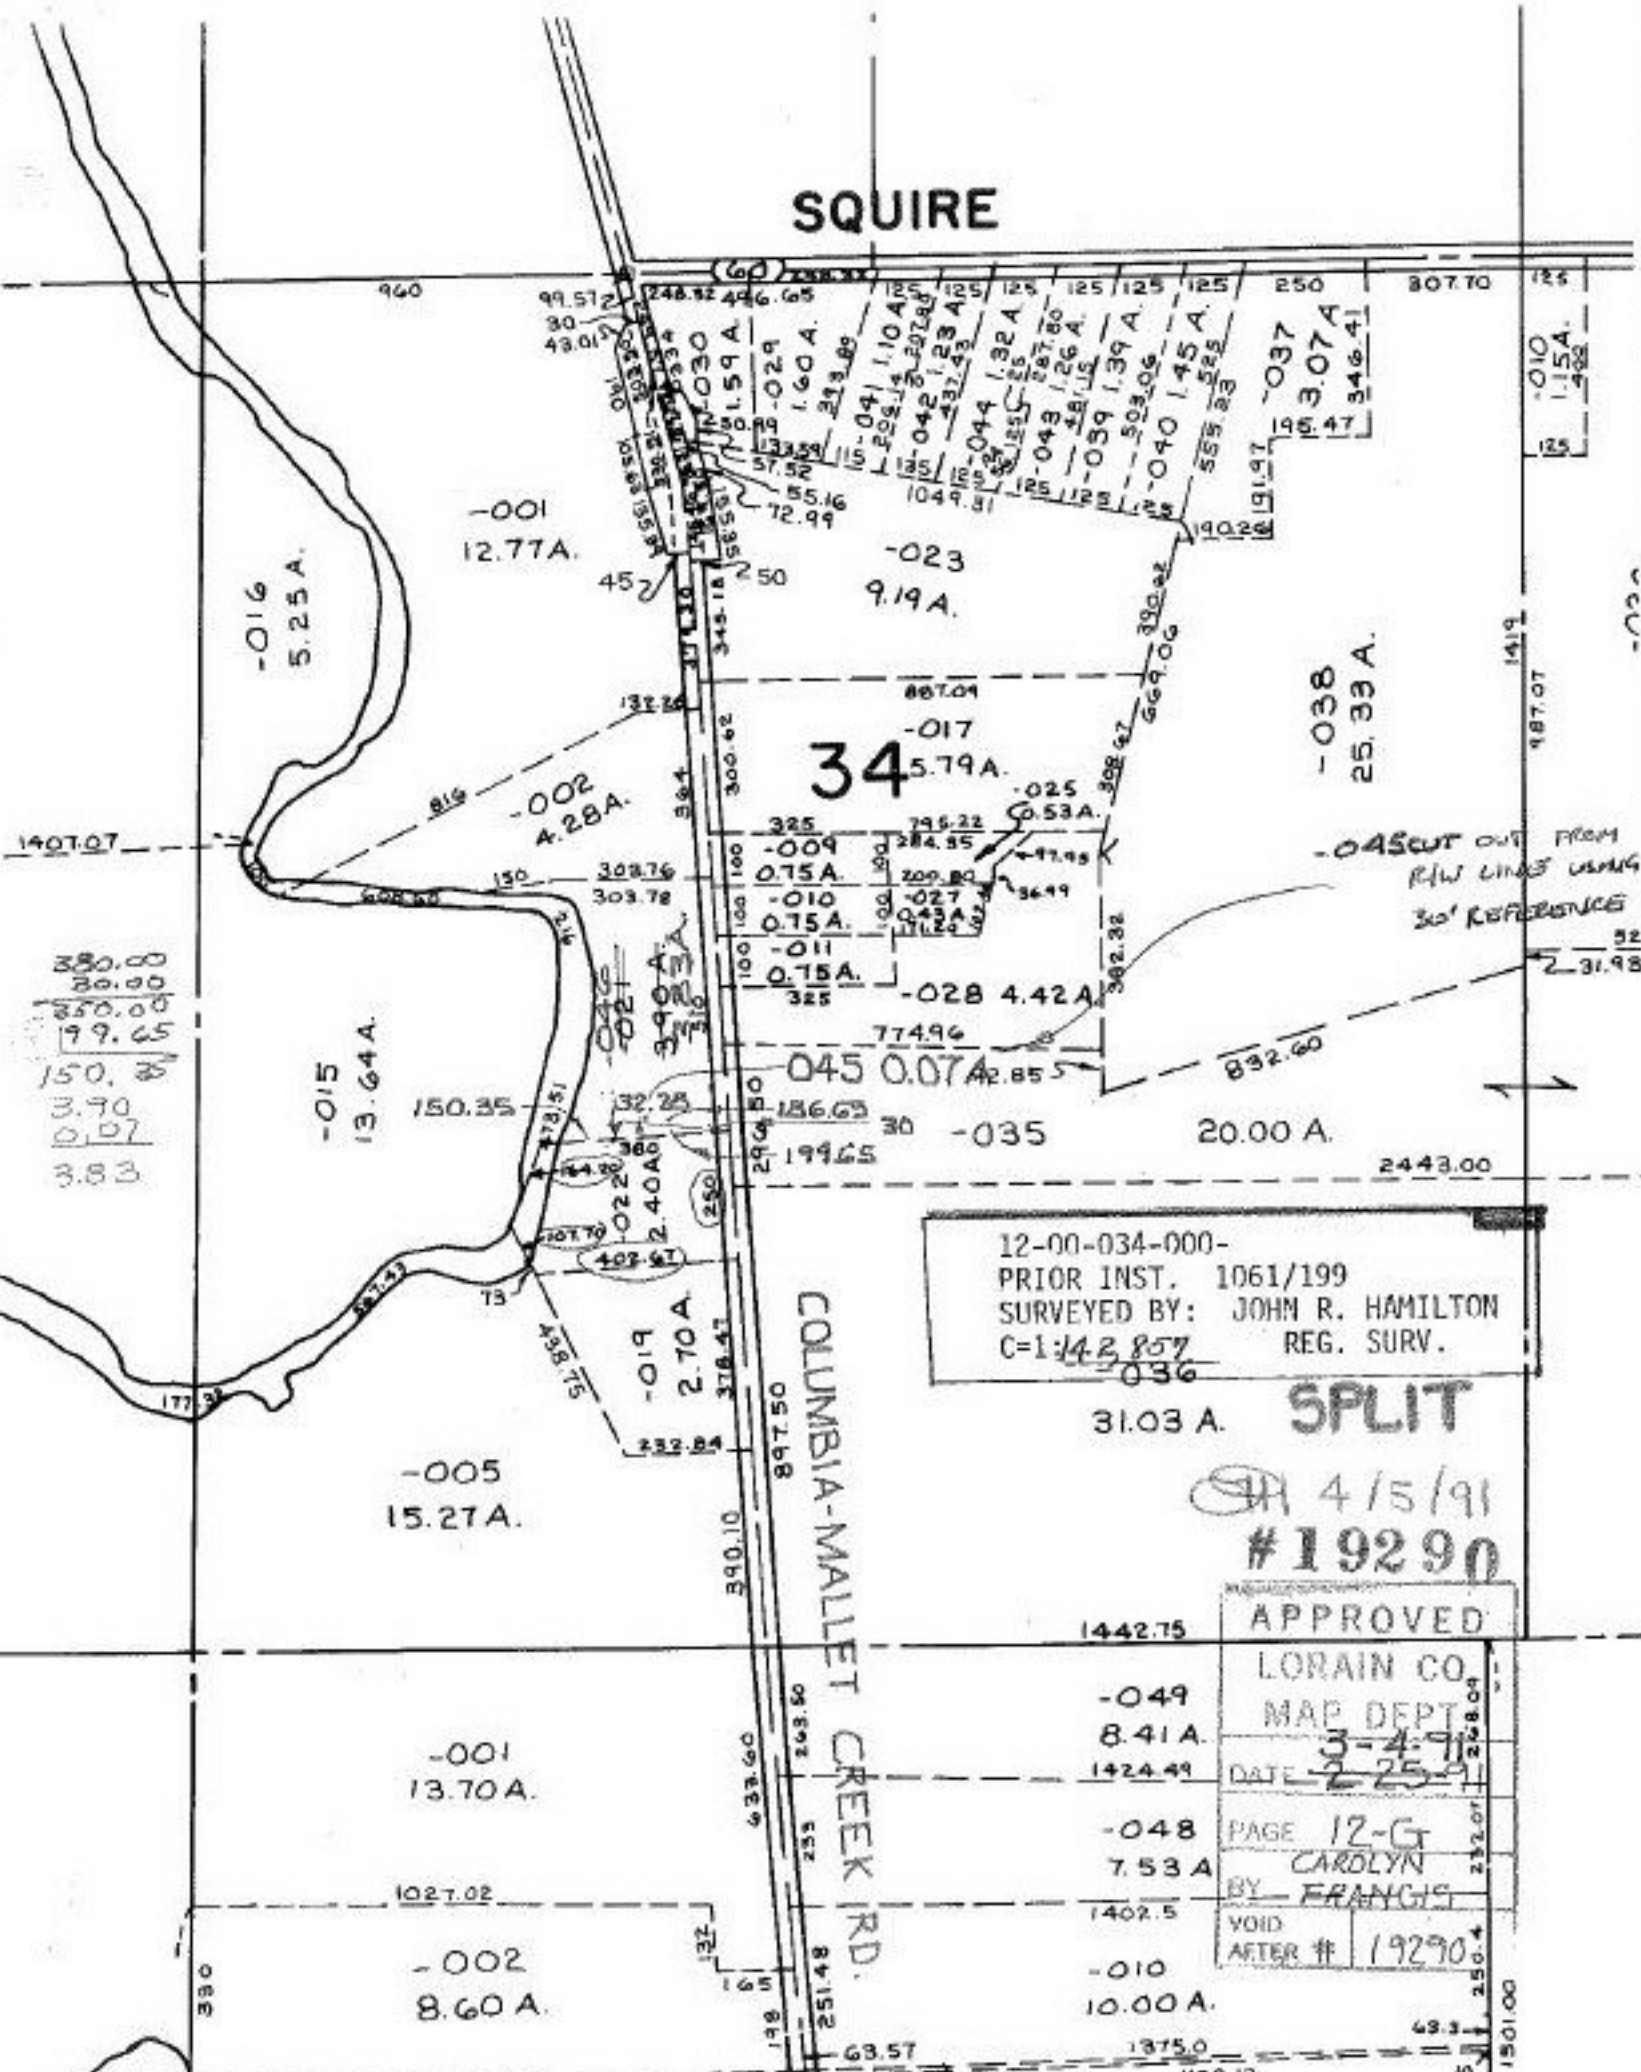

380.00
 30.00
 350.00
 99.65
 150.35
 3.70
 0.07
 3.83

12-00-034-000-
 PRIOR INST. 1061/199
 SURVEYED BY: JOHN R. HAMILTON
 C-1: 42,857 REG. SURV.

-045 cut out from
 R/W lines using
 30' REFERENCE

31.03 A. **SPLIT**
 4/5/91
 #19290

APPROVED
 LORAIN CO.
 MAP DEPT.
 DATE 3-4-91
 2-25-91
 PAGE 12-G
 CAROLYN
 BY FRANCIS
 VOID
 AFTER # 19290

1442.75
 -049
 8.41 A.
 1424.49
 -048
 7.53 A.
 1402.5
 -010
 10.00 A.
 1375.0
 1108.13
 1501.00

-001
 13.70 A.
 1027.02
 -002
 8.60 A.

COLUMBIA-MALLET CREEK RD.