

STEEL PLATE

0.80 A.

253.05

140.93

TO CL


1551.59

SEE 10-00-013-E

10-00-013-F

Pt. -228

Pt. 40.17 A.

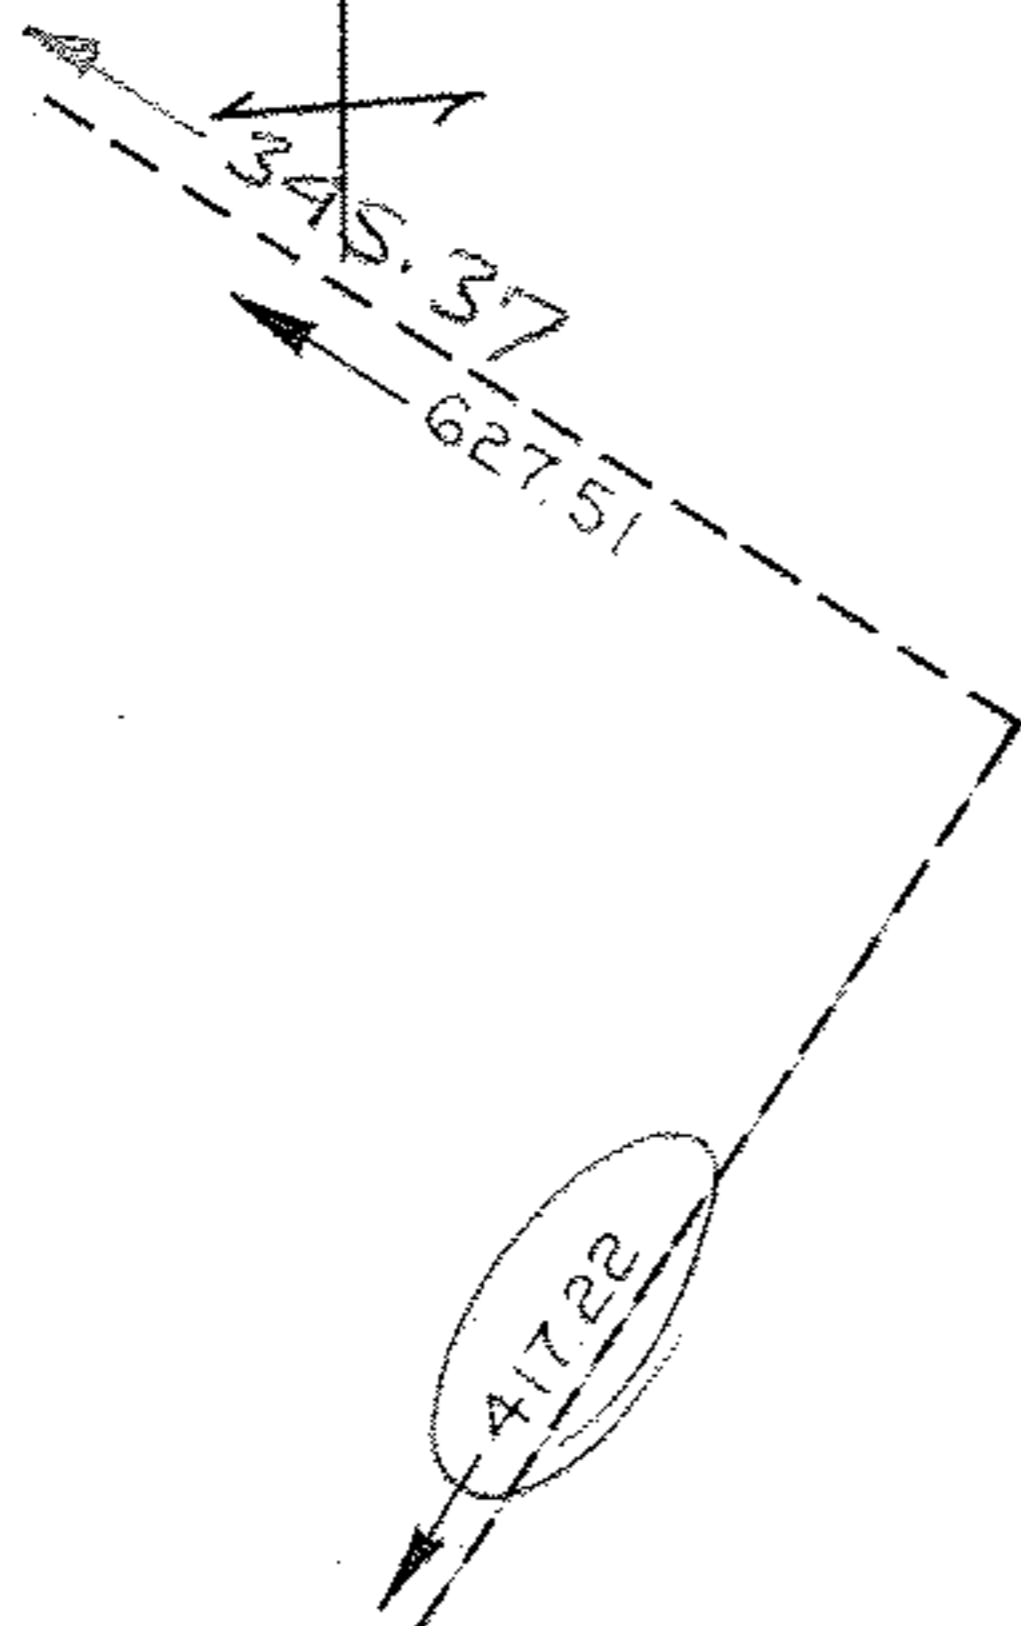

ON 4/11/91
#19303

APPROVED	
LORAIN CO.	
MAP DEPT.	
DATE 3-13-91	
PAGE 10.00.013-F	
BY Tom Main	
VOID AFTER	19303

TO CL 1561.56

S.R. 301

1161.00

LATASBURG ELYRIA