


WOODHILL  
ACRES  
SUB.  
NO. 1  
VOL. 20  
PG. 15A

SIZE CORRECTION PER PLAT  
NORTH ORCHARD HILL SUB. NO. 1  
VOL. 24 PG. 35  
TAX MAP O.K.

SEE

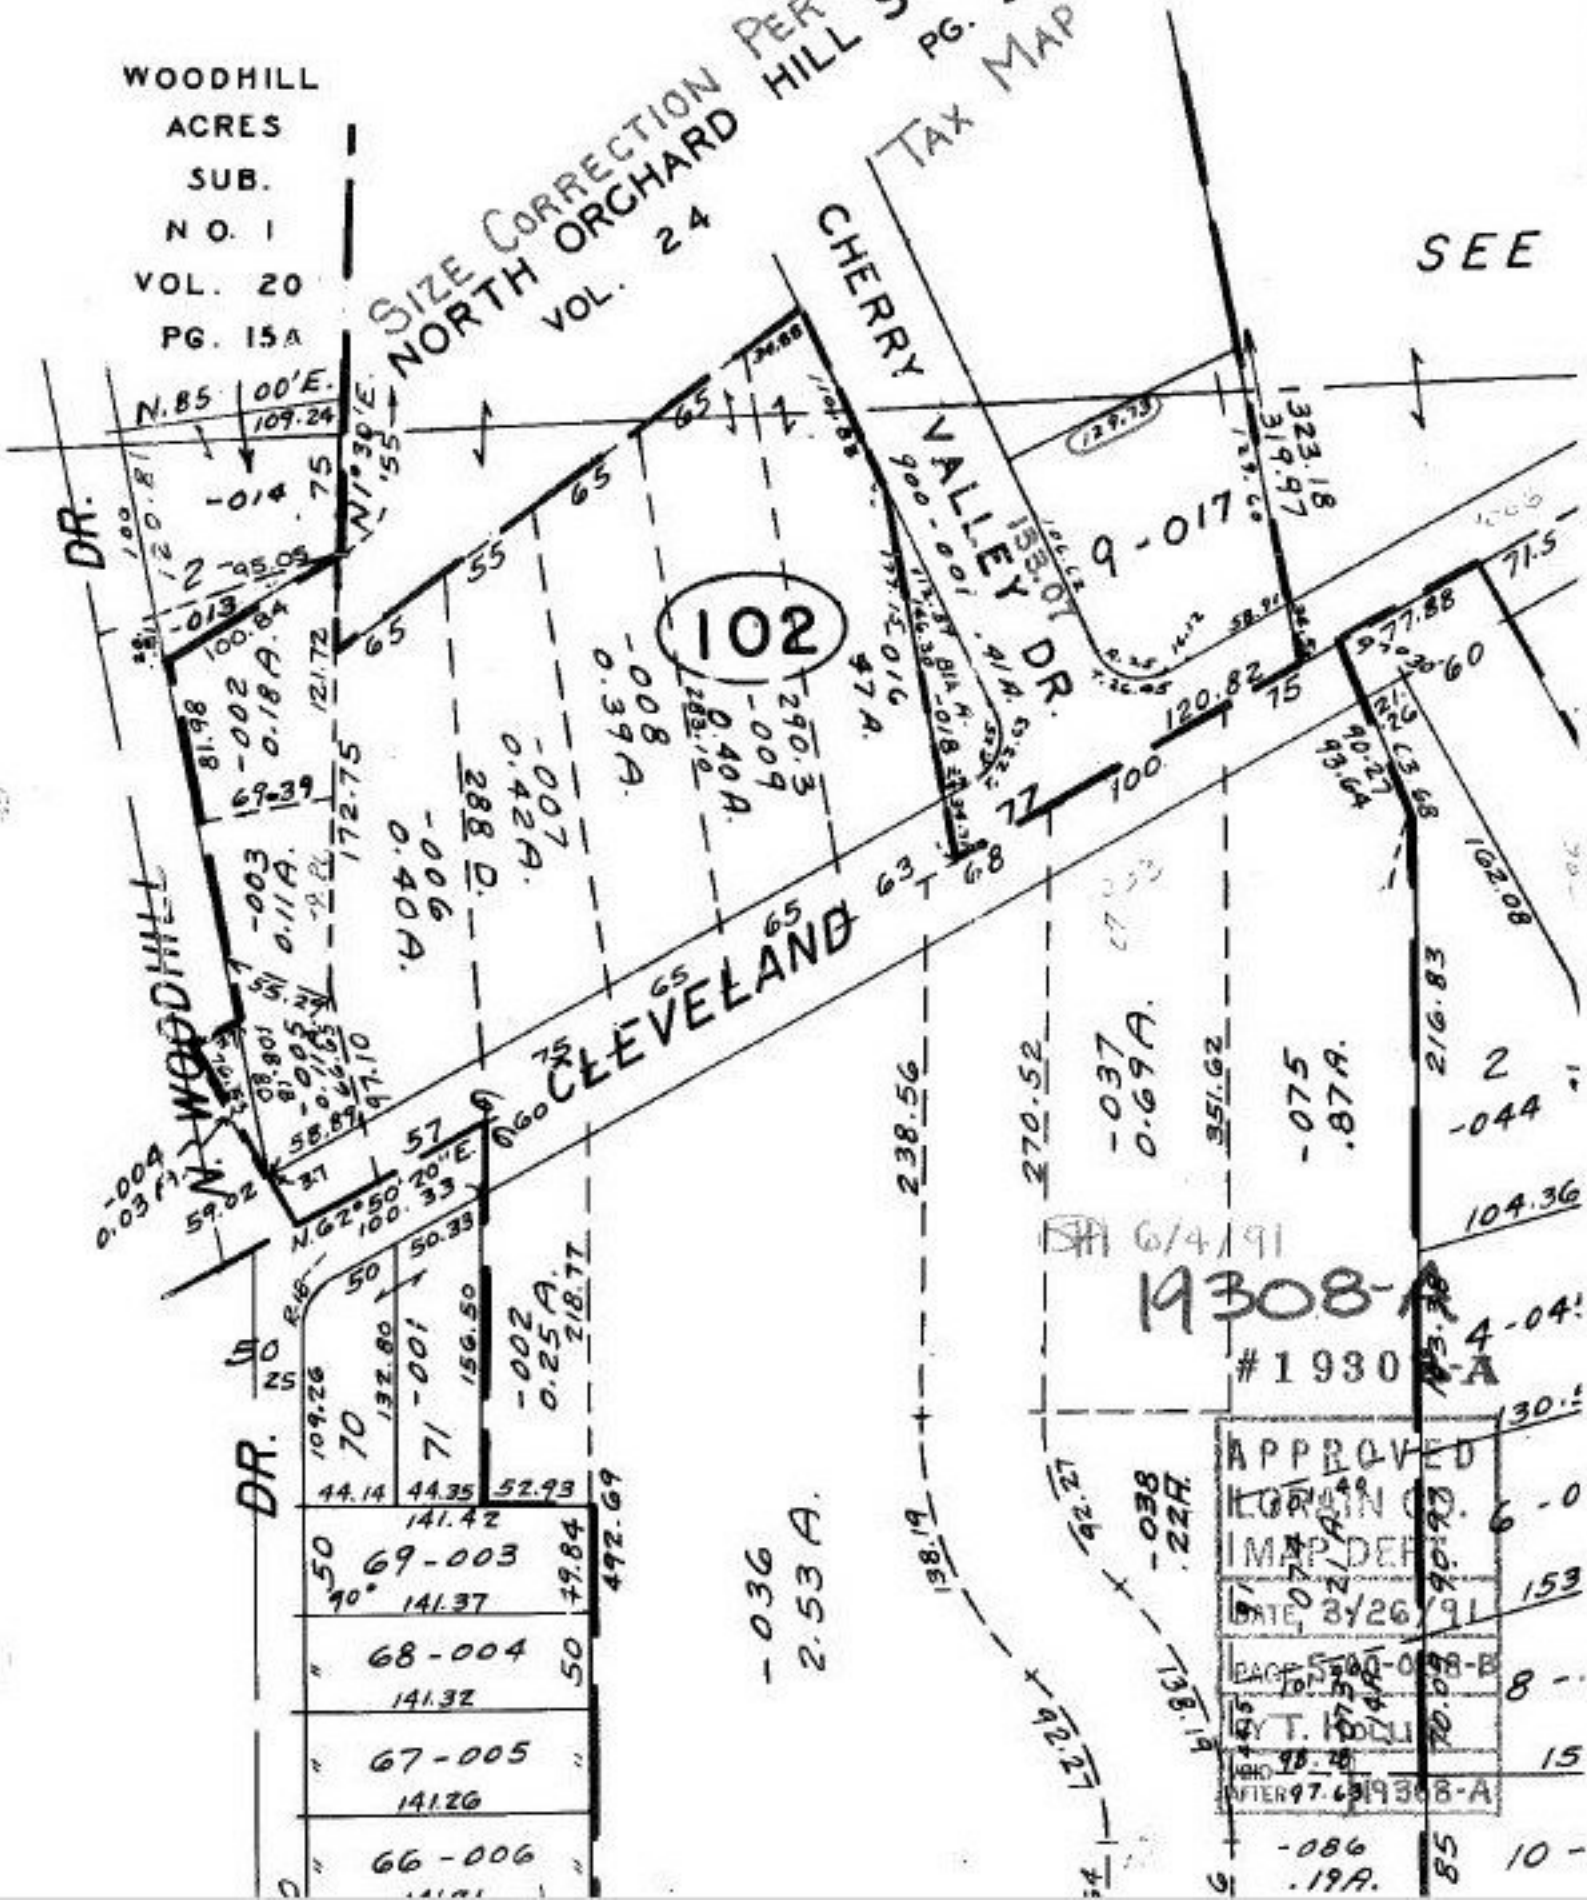

DR. 25	109.26	44.14	44.35	52.93
50	141.42	69-003	141.37	79.84
70	132.80	68-004	141.32	50
71	100	67-005	141.26	"
72	156.50	66-006		"
73	100.33			492.69
74	50.33			
75	50.33			
76	100.33			
77	100.33			
6/4/91  
19308-  
#1930  
APPROVED  
FOR  
IMPROVEMENTS  
DATE 07/26/91  
BY T. J. BOLL  
AFTER 97.6/19308-A

-036  
2.53 A.

REC.  
22H.

4-04!	30.!
6-0	153
8-	15
10-	