

THIS PARCEL IS BEING ADDED TO DUPLICATE, AS IT WAS A REMAINDER OF SPLIT #18561, TRANS. SHEET # 14, DATED 8-7-89, BUT WAS NEVER SHOWN ON THE MAP. ACREAGE WAS REDUCED TO 0.00 A. BUT IS BEING RESTORED TO 0.56 ACRES. PER CALCULATION OF MAP DEPARTMENT. PARCEL WAS DELETED WHEN 100-1-00-014-C & 7-00-013-A were drawn. REFERENCE DV. 1301/599

-118
7.68 A.

TO DUP.
TO AD
BUTTERNUT

SEE 7-00-013-A

07-00-014-103-

01-00-013-00-122
01-00-013-00-121
01-00-013-00-120
01-00-013-00-119
01-00-013-00-118
01-00-013-00-117
01-00-013-00-116
01-00-013-00-115
01-00-013-00-114
01-00-013-00-113
01-00-013-00-112
01-00-013-00-111
01-00-013-00-110
01-00-013-00-109
01-00-013-00-108
01-00-013-00-107
01-00-013-00-106
01-00-013-00-105
01-00-013-00-104
01-00-013-00-103
01-00-013-00-102
01-00-013-00-101
01-00-013-00-100

4/25/91
#19309-A

APPROVED
LORAIN CO.
MAP DEPT.

DATE 3-26-91


PAGE 7-00-014-C
CAROLYN
BY FRANCIS

VOID
AFTER

19309-A

RIDGEVILL

SCALE: 1" = 100'

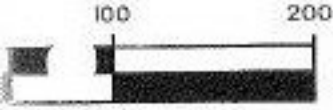

1/4 LOT 14

