

5. 63° 00' 00" W
CEDAR BR
 10' UTILITY EASEMENT
 13.50' MINIMUM BLDG


S. 31° 00' 23" W
 R. 96.65' C. 192.81'
 A. 108.40 T. 60.70'
 Δ. 64° 15' 55"

S. 31° 00' 23" W
 R. 46.65' C. 49.62'
 A. 52.32' T. 29.30'
 Δ. 64° 15' 55"

N. 23° 52' 17" E
 R. 20.00' C. 16.90'
 T. 9.32' A. 17.45'
 Δ. 49° 59' 06"

S. 26° 07' 27" E
 R. 20.00' C. 16.90'
 T. 9.32' A. 17.45'
 Δ. 49° 59' 06"

CERTIFICATE OF
 CORRECTION
 4.90731

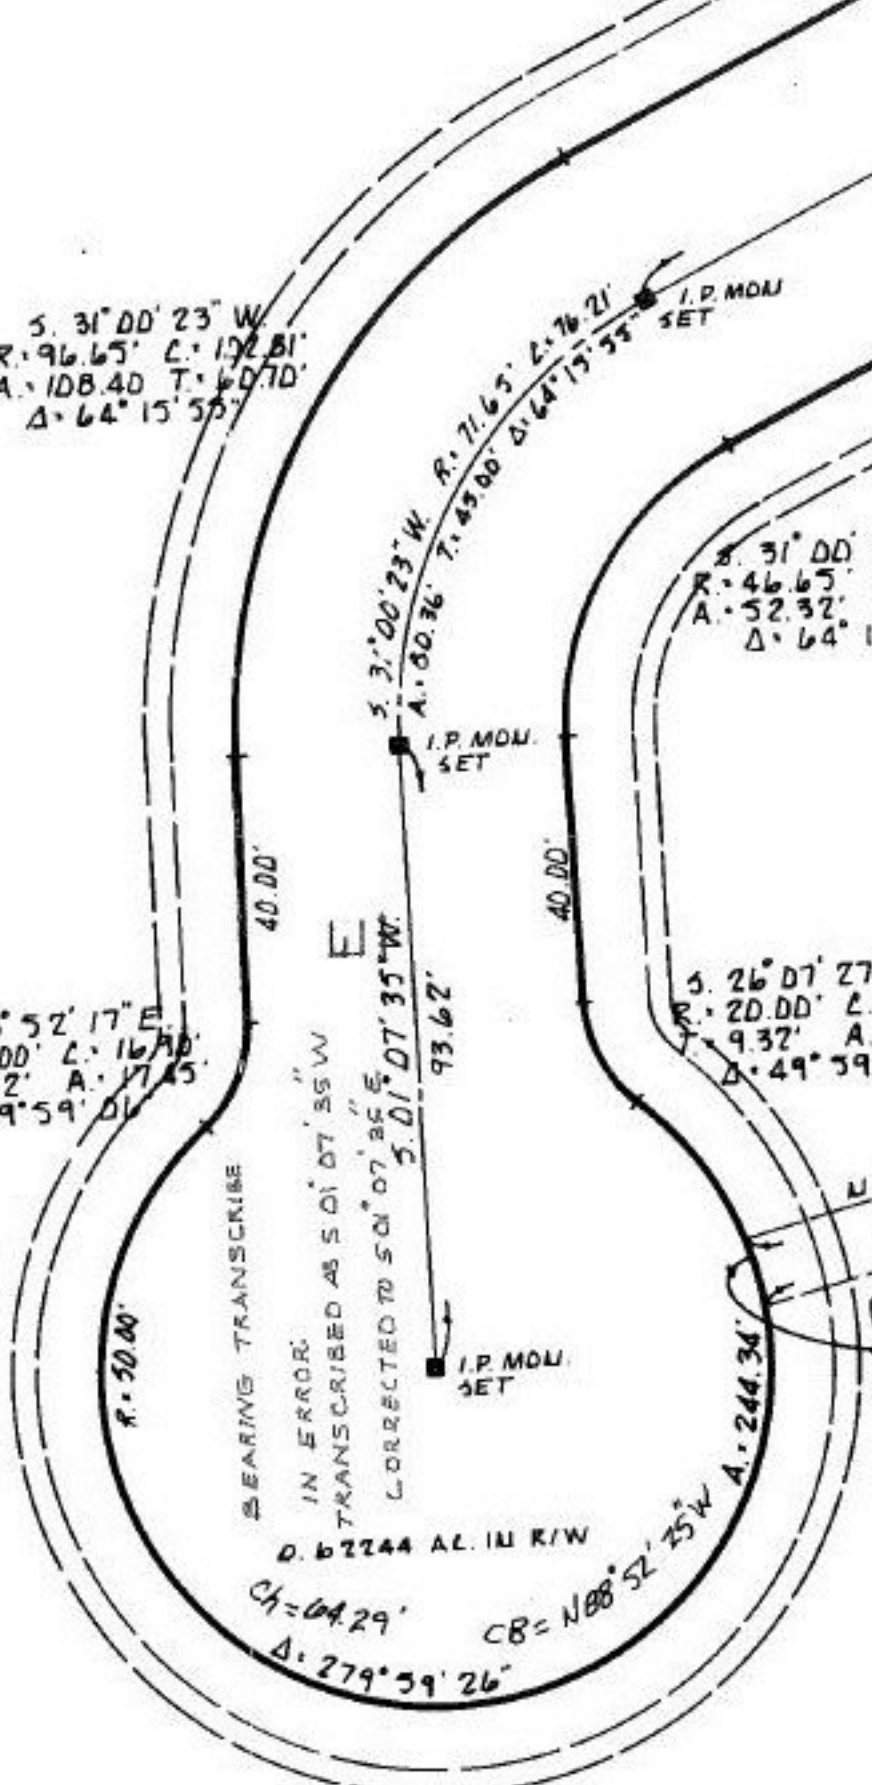

BEARING TRANSCRIBE
 IN ERROR.
 TRANSCRIBED AS S 01° 07' 35" W
 CORRECTED TO S 01° 07' 26" E
 S. 01° 07' 35" W
 93.62'

D. 62244 AL. IN R/W

CH = 64.29'
 Δ. 279° 59' 26"

S. 73° 05' 33" W
 R. 77.02' C. 77.02'
 A. 10.01' T. 5.02'
 Δ. 11° 28' 01"

N. 73° 05' 33" E
 77.02'
 10' SEWER EASEMENT
 89.81' & DEWASHE 65W

DP/AM/JCK/IO
 5/24/94
 TM/TM

#19316A

APPROVED	
LORAIN CO.	
MAP DEPT.	
DATE	4-9-91
PAGE	7-00-007-D
BY	CAROLYN FRANCIS
VOID AFTER #	19316A

CORRECTION TO PLAT
 VOL 45 PG 73
 OR 374/722

07-00-007-900-002

173.66'
 01° 16' 09" E
 20' SEWER EASEMENT & DEWASHE 65W