


275.17
540.00
+ 176.47
1091.64

Max. Box RUSSIA

2688.97

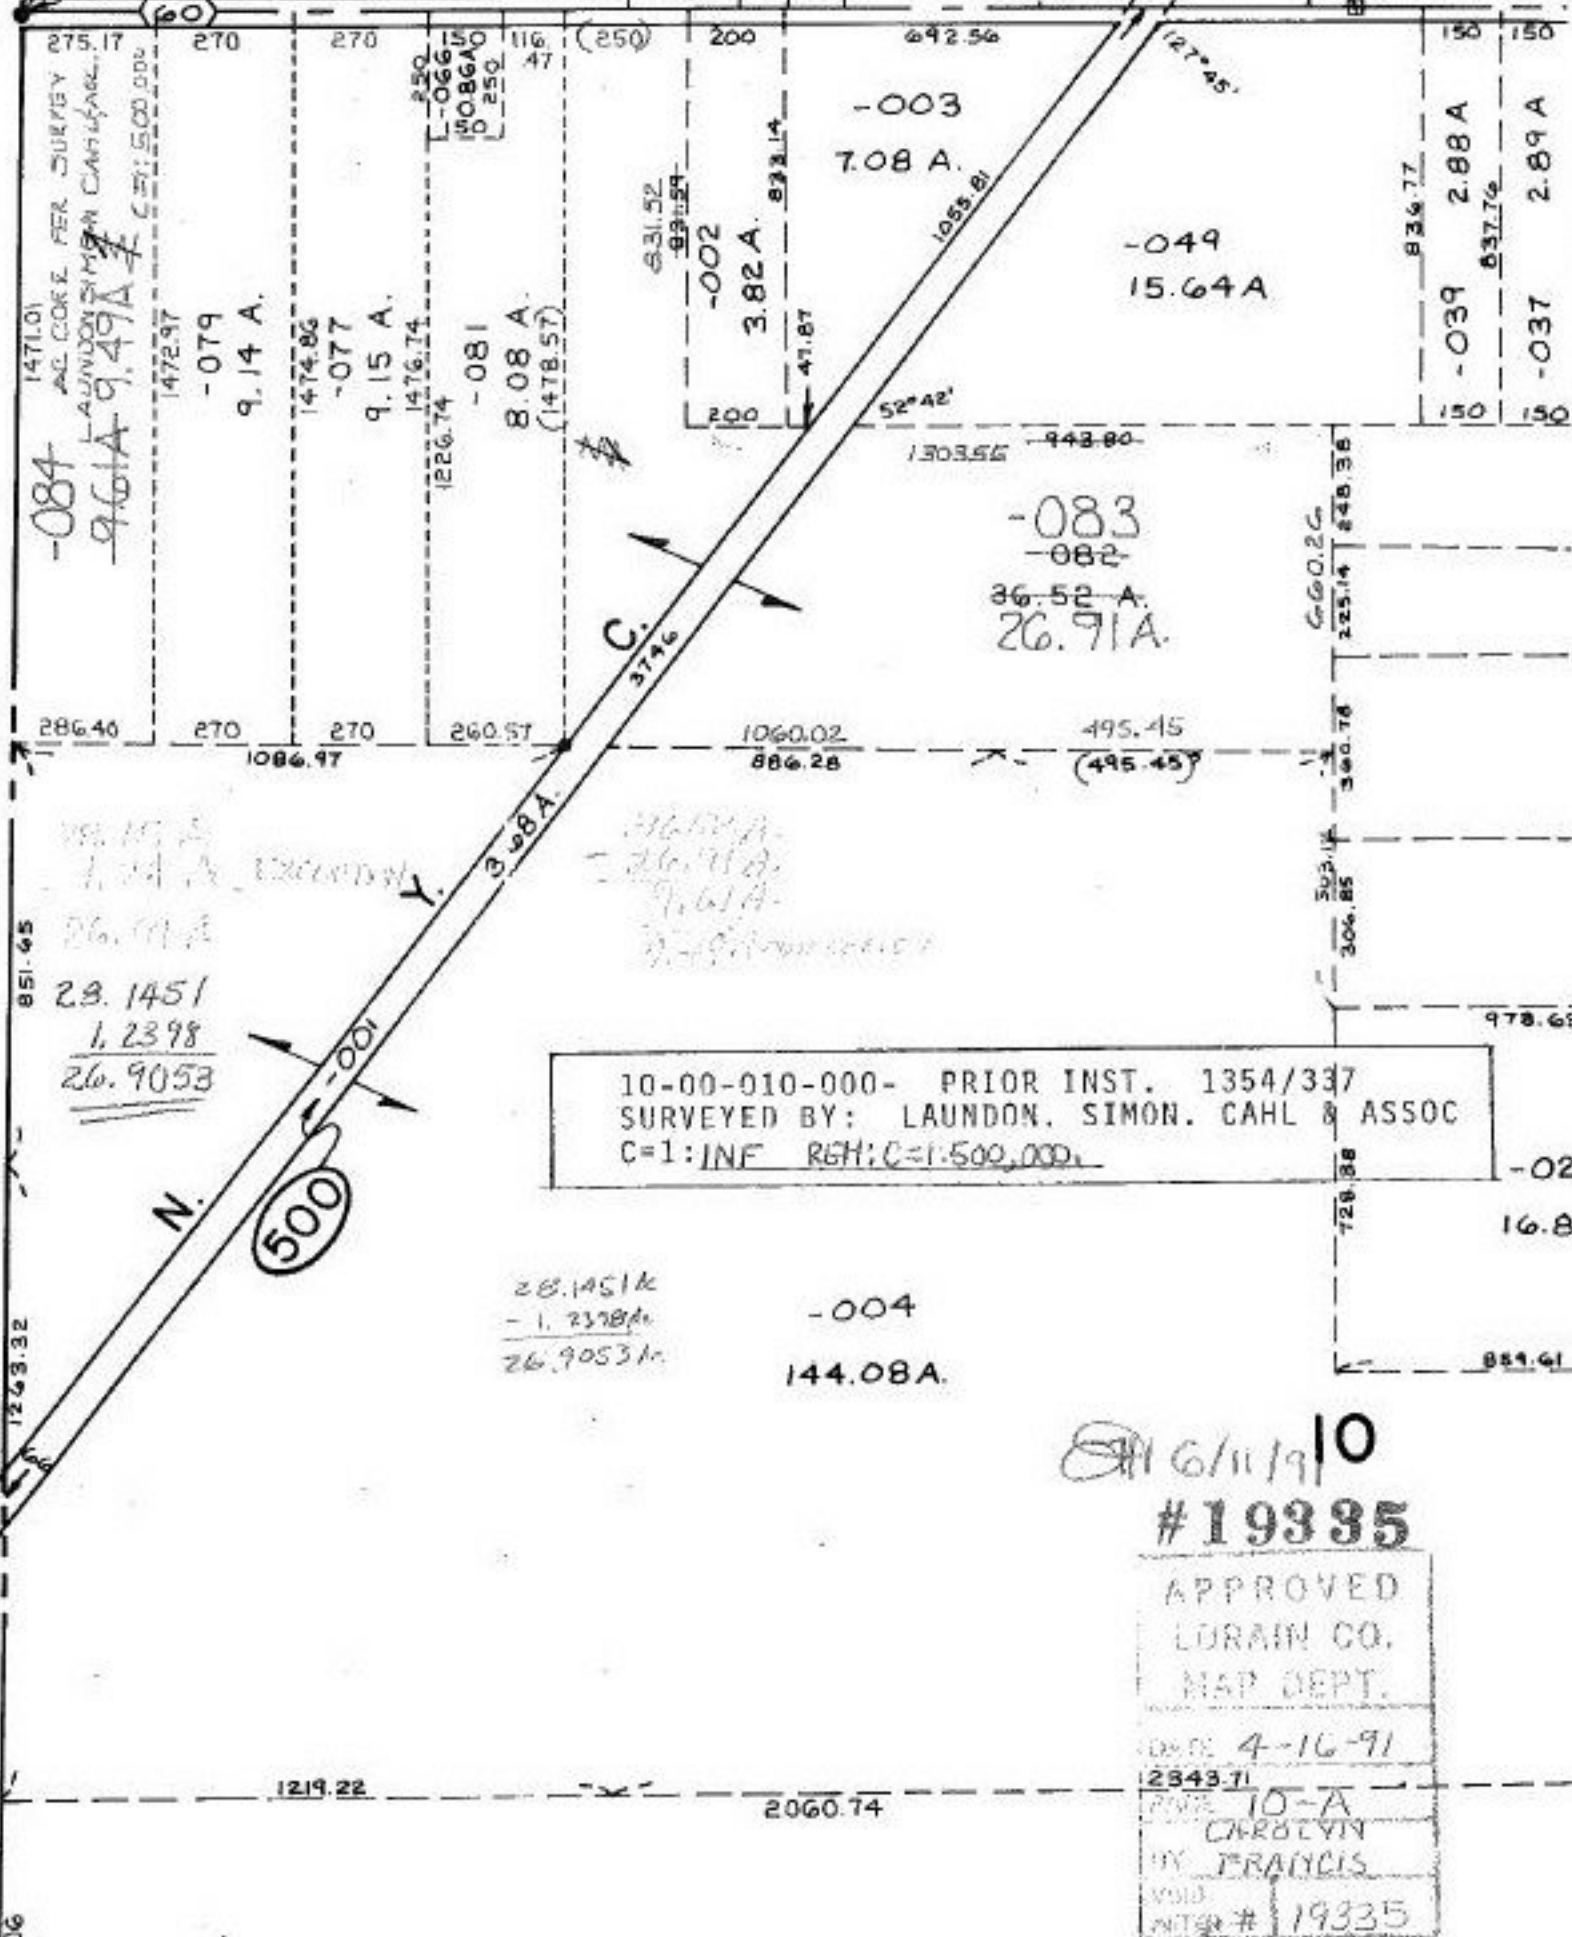

1471.01
AC. COR. PER SURVEY
LAUNDON SIMON CAHL & ASSOC.
9.61A 9.49A
1472.97

275.17
270
270
-079
9.14 A.
1474.86
-077
9.15 A.
1476.74

116.47
250
-066
150.86A
250
-081
8.08 A.
(1478.57)

200
200
-002
3.82 A.
833.14
47.87
52°42'

642.56
-003
7.08 A.
1055.81
127°45'

150
150
-049
15.64 A.
834.77

150
150
-039
2.88 A.
837.76
-037
2.89 A.

286.40
270
270
260.57
1086.97

379.6
3.98 A.

1060.02
886.28

495.45
(495.45)
-083
-082
36.52 A.
26.91 A.

660.26
225.14
340.78

978.65
-02
16.8
851.61

851.65
26.91 A
28.1451
1.2398
26.9053

N.
500

28.1451
- 1.2398
26.9053

-004
144.08 A.

10-00-010-000- PRIOR INST. 1354/337
SURVEYED BY: LAUNDON, SIMON, CAHL & ASSOC
C=1:INF RGH: C=1:500,000.

6/11/91
#19335

APPROVED
LURAIN CO.
MAP DEPT.
DATE 4-16-91
2343.71
10-A
CAROLYN
BY FRANCIS
VOID
NOTES # 19335

8.06

1219.22

2060.74