

SEE 5-00-095-C

831.60


05-00-007-000-011 3.03A

-07A-105-012 11.43A

-095-000-07B 5.00 A

~~19.46A~~

AC. CORE PER SURVEY
BY CHARLES WARYU
REG SURVEYOR
SCALE: 500,000

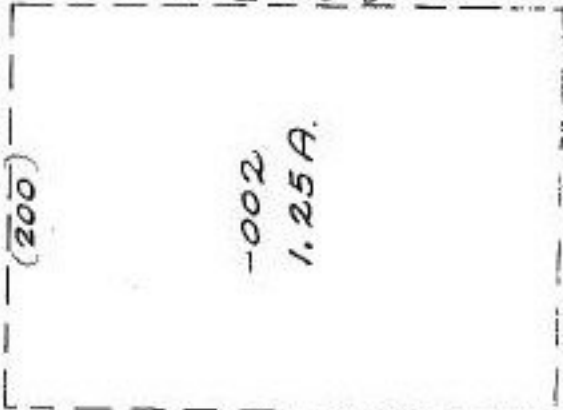

105

-002
1.25A.

473.14
275
264

473.14
473.64

273.36

20

-023
~~19.46A~~
18.13A

~~-012~~
11.43A.
~~10.207A~~

SA 6/4/91
#19338-A

APPROVED
LORAIN CO.
MAP DEPT.
DATE 4-24-91
PAGE 5-00-074-C
CAROLYN
FRANCIS
VOID # 19338-A
NETS

TURNPIKE

-003
6.18A.

RIDGE
MIDDLE
9410 S

MO. ST. RD.

RD.

202.07

371.82

169.15

161.12

M.S. RD.

89.17

1197.70