

23.03 A
0.21 A
27.82 A

-005
27.00 A.
190.82
15.80
125.02

-006
8.00 A.

COMBINATION
05-00-074-000-005 0.38 A
SPLIT -006 @ 21A
05-00-087-000-013 0.01 A

AMN TWP
Elyria City
1211.98
850

-009
14.62 A.

05-00-074-000- C=1:500,000 SPLIT
05-00-087-000- or Comb. O.R. 280/275
PRIOR INST. 280/668
SURVEYED BY: CHARLES WARVU
1404.05 REG. SURV.
654.01

750 ELYRIA CITY
AMN TWP
558.50

OL.74 OL.87

AC. CORE
CHARLES WARVU
REG. SURVEYOR
C=1:114,705

-001
71.75 A.



05-00-074-000-007 27.82 A
125.02
-004 140.82

74

-002
45.00 A.

-007
28.03 A. 27.82 A.


SCALE
"DETAIL"
1" = 100'

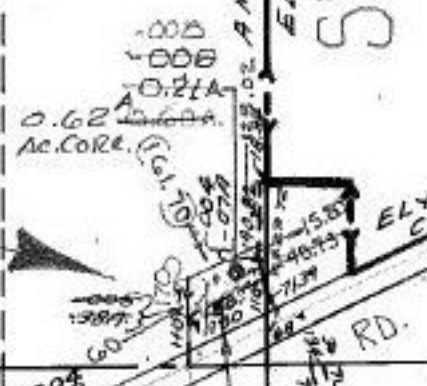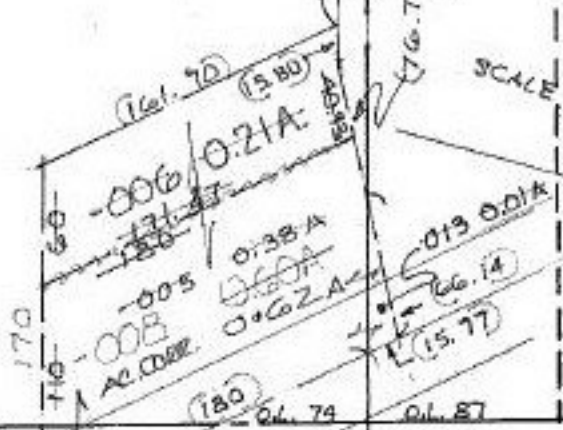

MILAN ELYRIA RD SR. 113
-025
22.00 A.

APPROVED
LORAIN CO.
MAP DEPT.
DATE 4-23-91
5-H
CAROLYN
FRANCIS
19342

MILAN ELYRIA
SR. 113
OL.73 OL.88

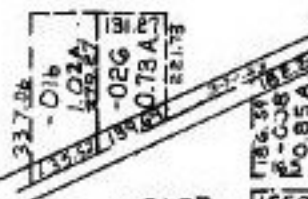

-009
52 A.

SPLIT & COMB.