


1937

APPROVED
LORAIN CO.
MAP DEPT.
 DATE 7-11-68
 4-E
 BY *Bohler*

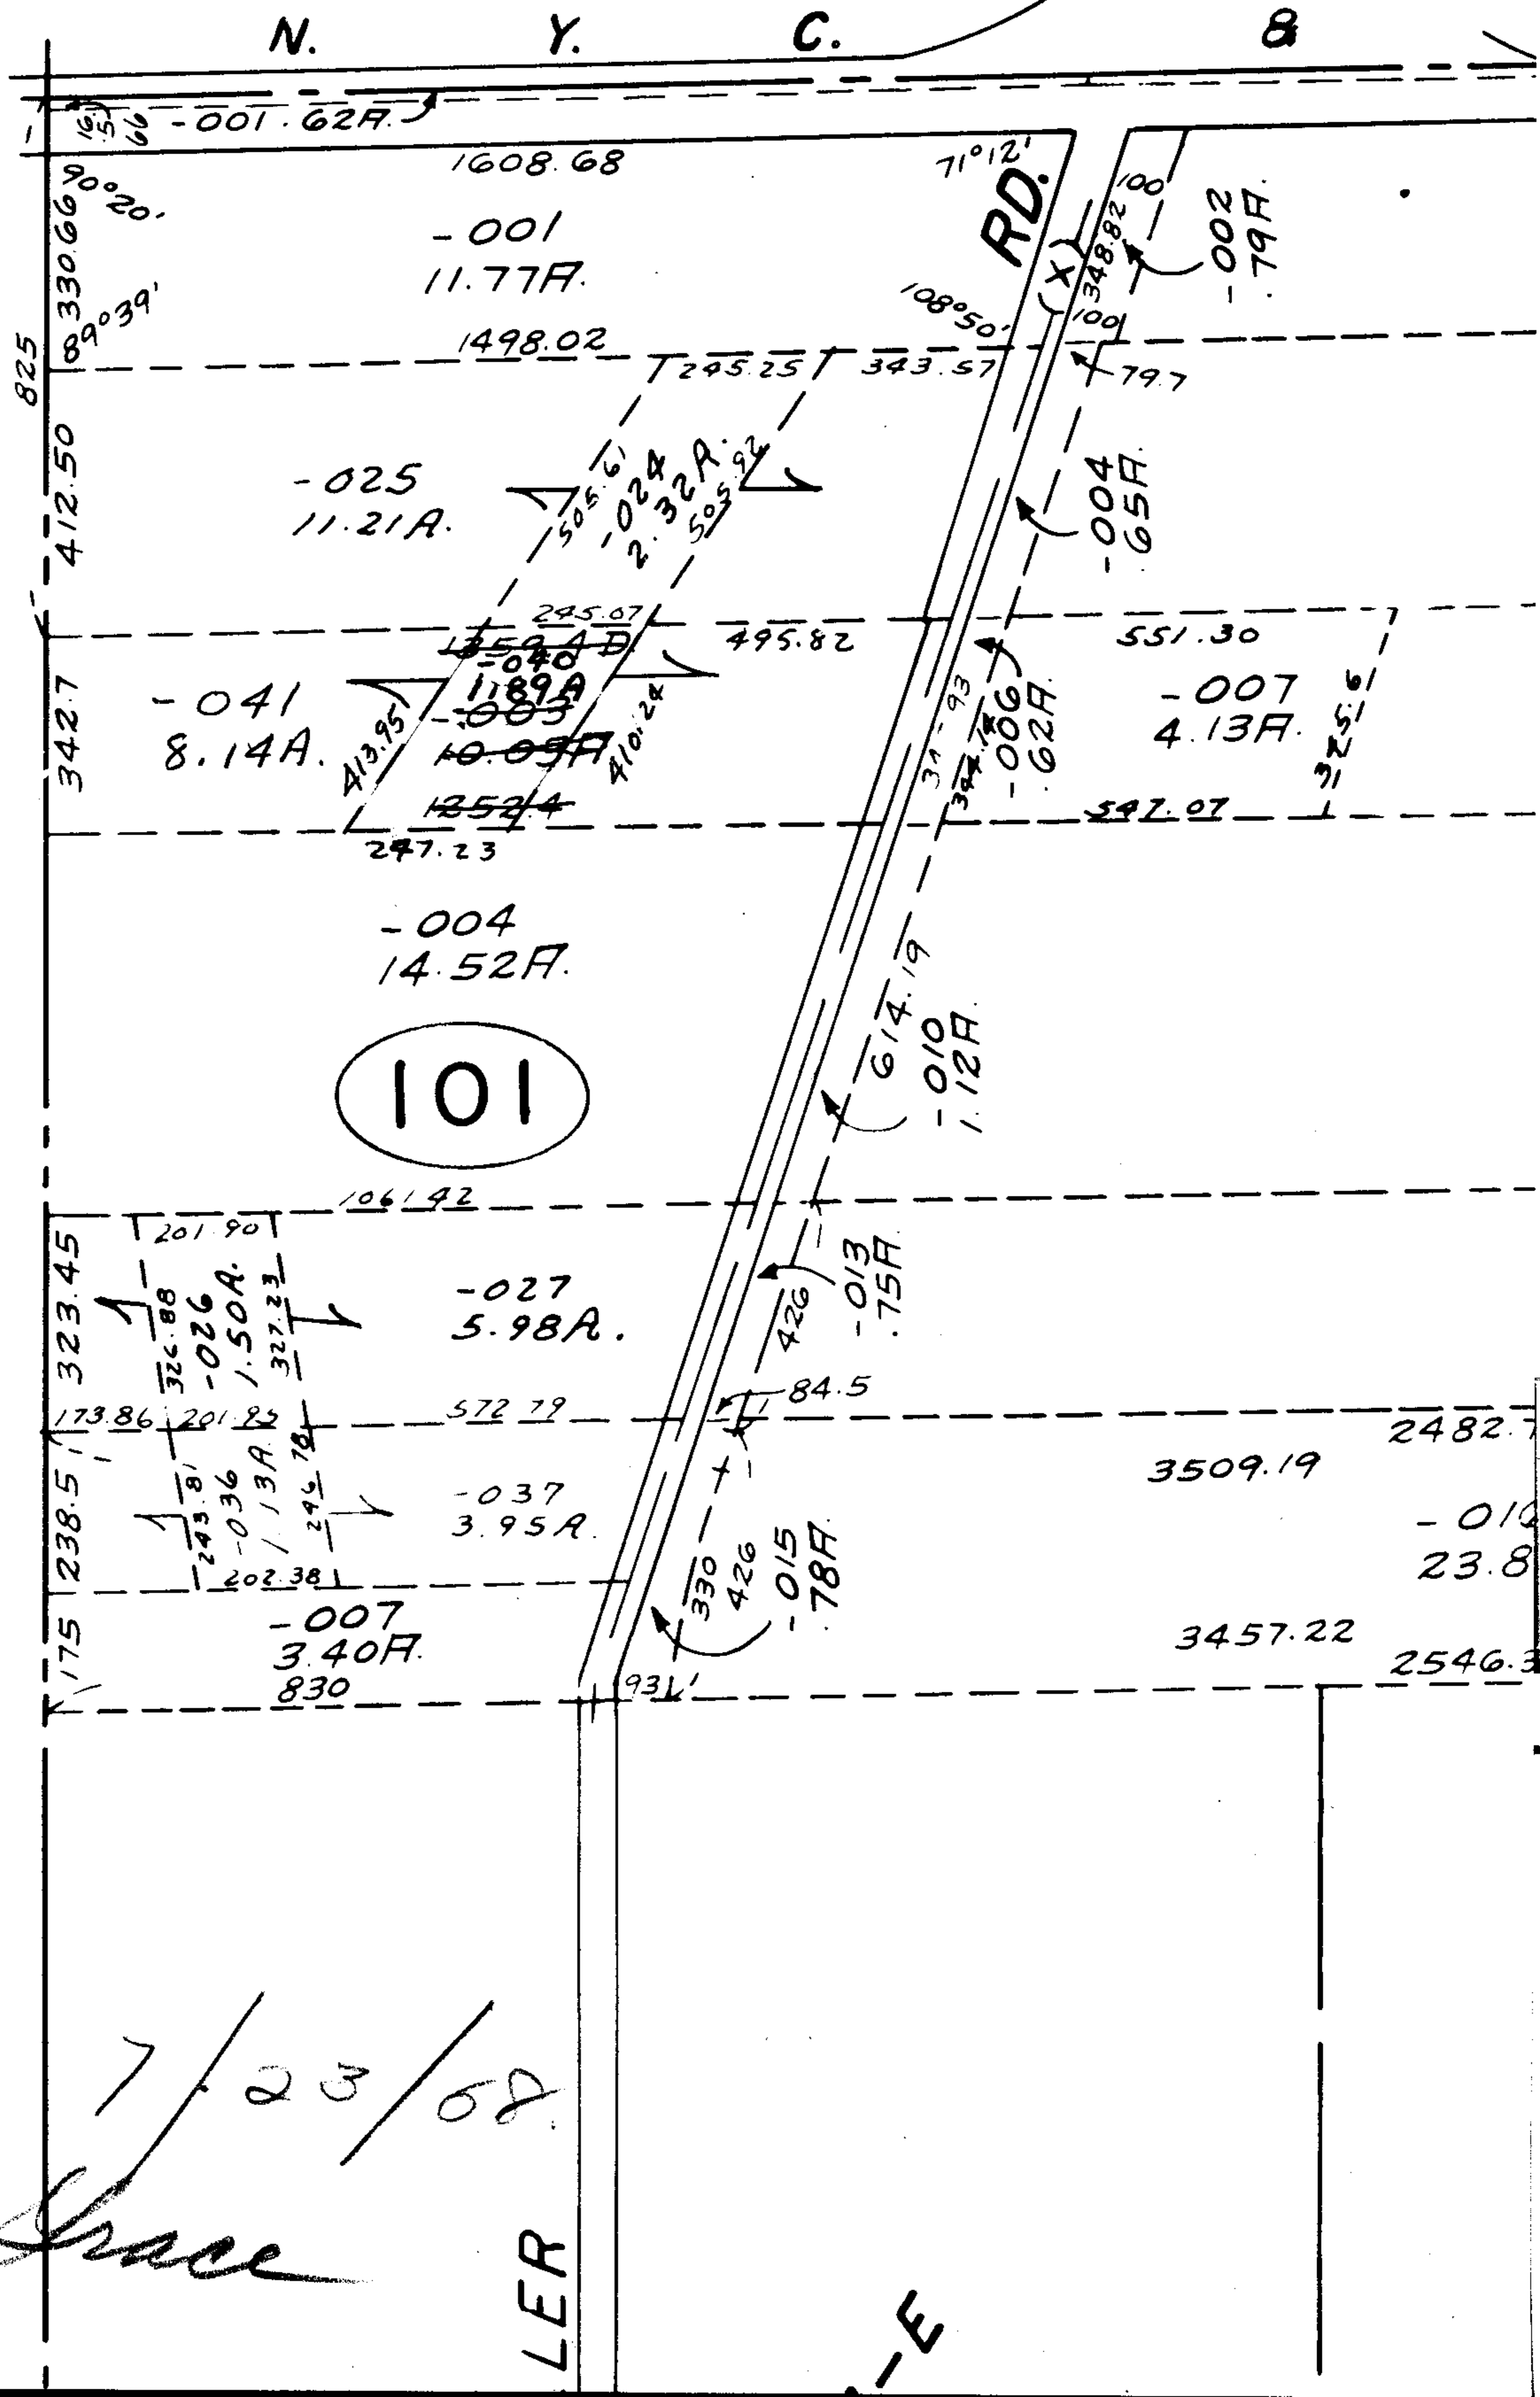

Done 7/23/68
Jim Race
 3-H
 LER

1003
 169
 814

10-1-68