

Pt. 51.88A.

7.16 A
 0.24 A
 6.92 A
 2.59 A
 4.53 A

1039.53

-071
 2.39 A.

-065

-4.60A.


101

50.01

92

0.24A

600

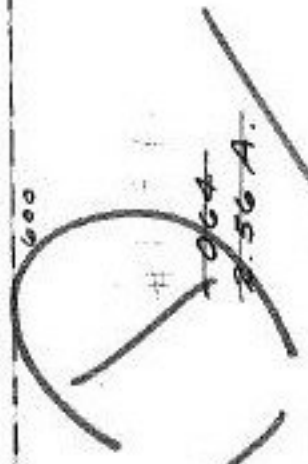

-072

4.53A.

~~1.06A.~~
~~3.56A.~~

186

1059.99

490

1241.89

-006
 3.06A.

600

W. J. 10.10.10

11.7

546.15 X
 -007
 545.03

664.64

SA 1/17/92

APPROVED

LORAIN CO.
 MAP DEPT.

DATE 5-16-91

PAGE 4-00-016-E

BY CAROLYN T. McNamee

VOID AFTER # 19371

19371

-051

AVON BELDEN

110

46.09

186

070

256

RD.