


ELYRIA-MEDINA RD.

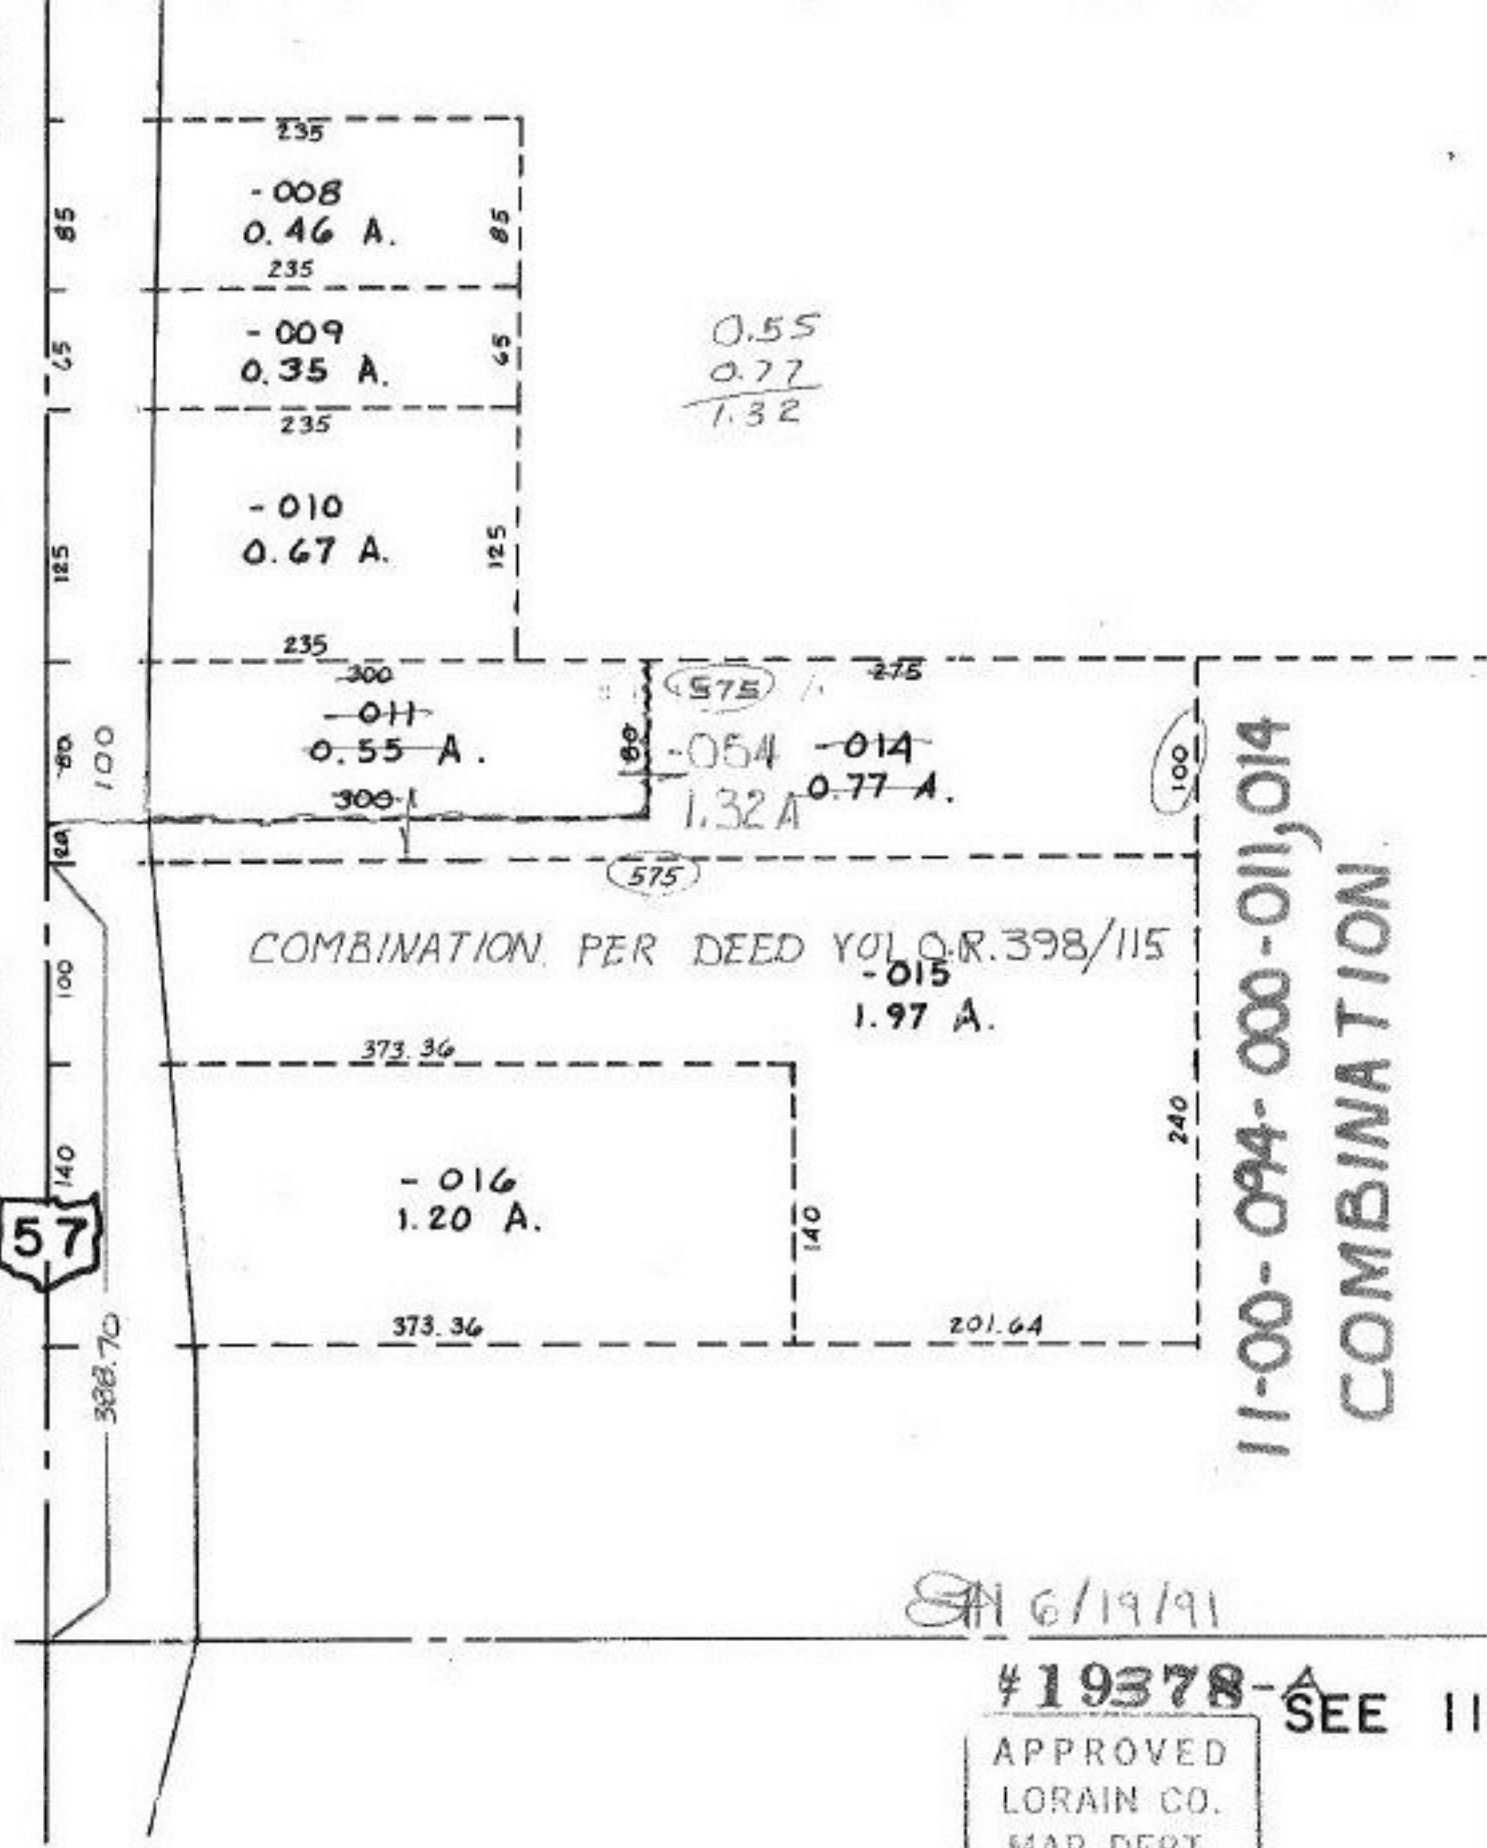

11-00-094-000-011,014
COMBINATION

SN 6/19/91

19378-A SEE II

APPROVED
LORAIN CO.
MAP DEPT.
DATE 6-12-91
PAGE 11-00-094-A
BY CAROLYN FRANCIS
VOID AFTER # 19478