


SEE 3-00-015-B

RD.

857.50
480.00

387.22


039
51.40 A.

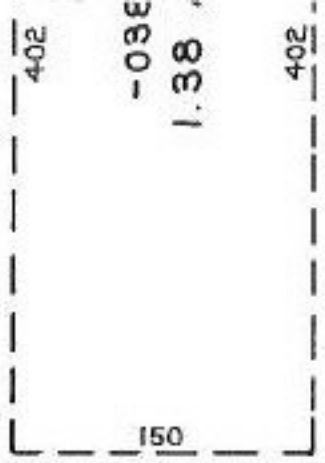

-040
4.26 Ae.

-041
48.06 A.

SEE SURVEY BY -
K S ASSOC.
PRIOR INST. OR 166/273
CL 1: 1x100

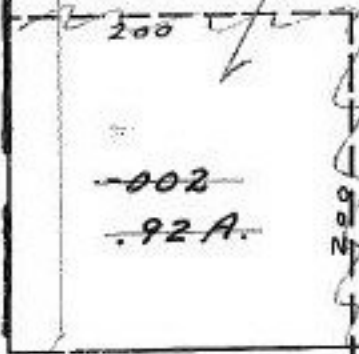

500

301.04
383.09
FRENCH-CREEK

300
PR. B.

-006
1.38 A.

10/31/91
#19383

APPROVED
LORAIN CO.
MAP DEPT.
DATE 8-2-91
PAGE 3-00-015-A
BY T. Moran
VOID AFTER 19383

300

200

200

101.12

45

200.25

55

55

55