


0-112-B

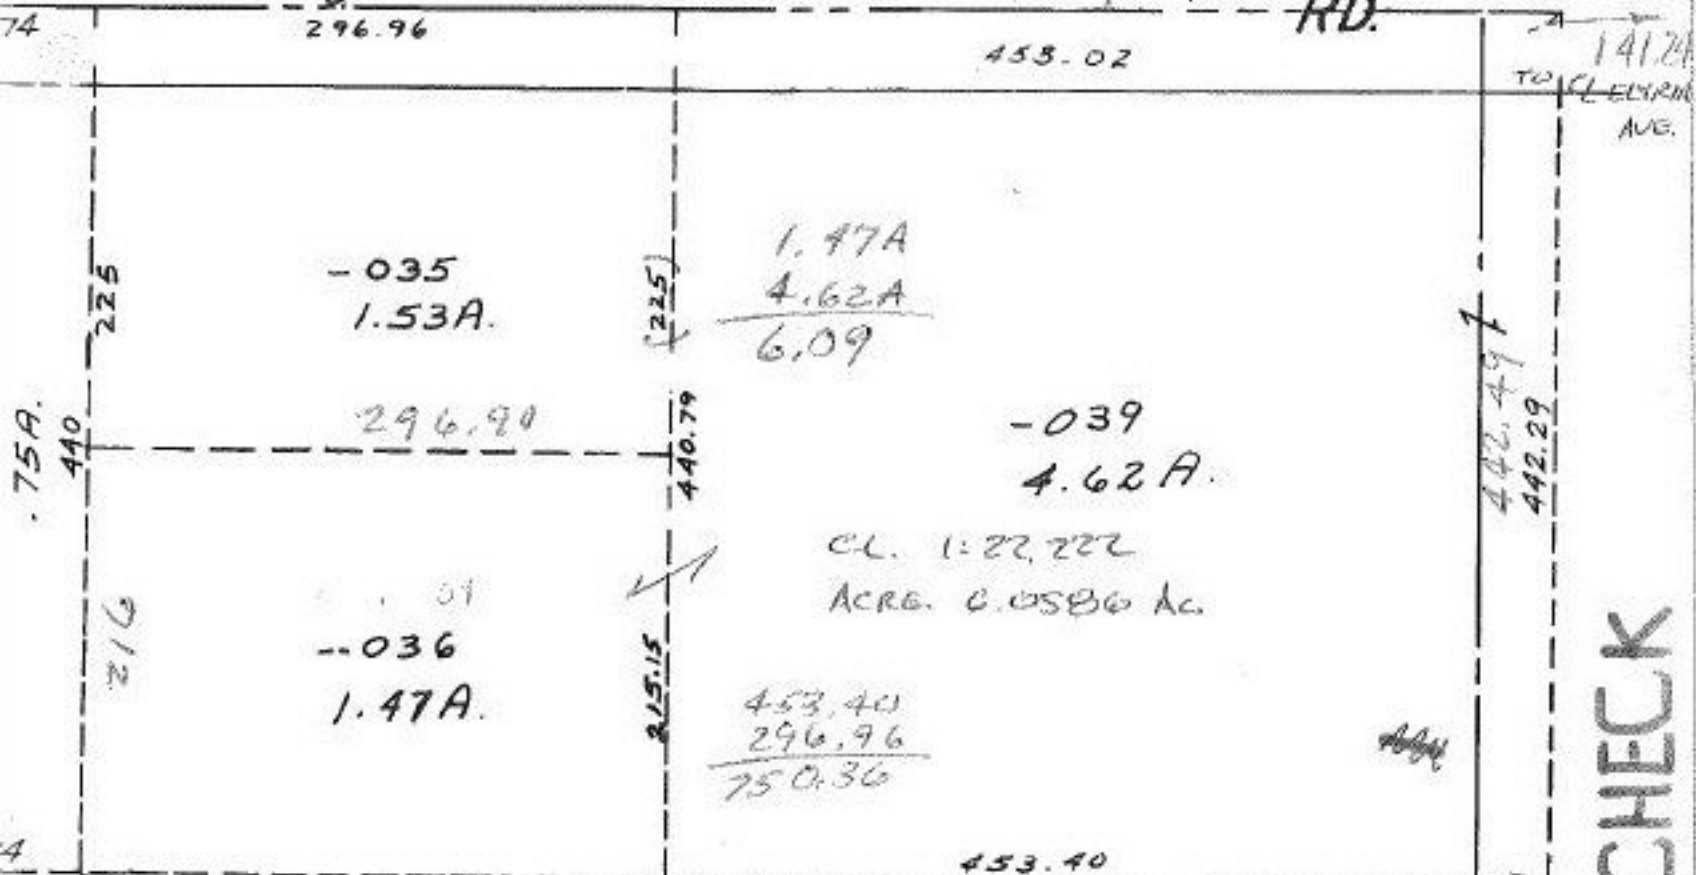

- (1) NEED SURVEY IF POSSIBLE.
- (2) TO DO AN ACREAGE CORRECTION, PARCELS MUST BE COMBINED AND ASSIGNED ONE NUMBER.
- (3) ACREAGE IS MISSING IN DESCRIPTION.

101

-027  
9.11A.

176/92  
#19389

DEED CHECK

APPROVED  
LORAIN CO.  
MAP DEPT.  
DATE 6-20-91  
PAGE 6-4  
BY CAROLYN FRANCIS  
VOID AFTER #19389

DEED CHECK

898.81