

49.04 A
0.53 A
 48.51 A
0.15 A
 48.36 A


-051
~~047~~
~~012~~
 49.04 A.
 48.36 A.

3 Parcel No. Corrections

6/4/91
 #19395-A

APPROVED
 LORAIN CO.
 MAP DEPT.
 DATE 5/30/91
 PAGE 5-00-002-B
 BY T. McMain
 VOID AFTER 19395-A

567.83
549.78
 18.05

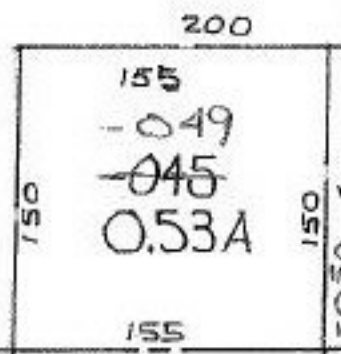

N. LAKE

OAK POINT

549.78 TO + OF LINE
 OF FORDE AVE AND E OF
 NORTH LAKE ST

103-B

05-00-002-000- PRIOR INST. 1306/166-173
 SURVEYED BY: PATRICK A. MCGANNON
 C=1:INF. REG. SURVEYOR

~~#19395-A~~
 APPROVED
 LORAIN CO.
 MAP DEPT.
 DATE 5-14-91
 PAGE 5-00-002-E
 BY CAROLYN FRANCIS
 VOID AFTER

#19395-A