





SEE 4-00-016-G

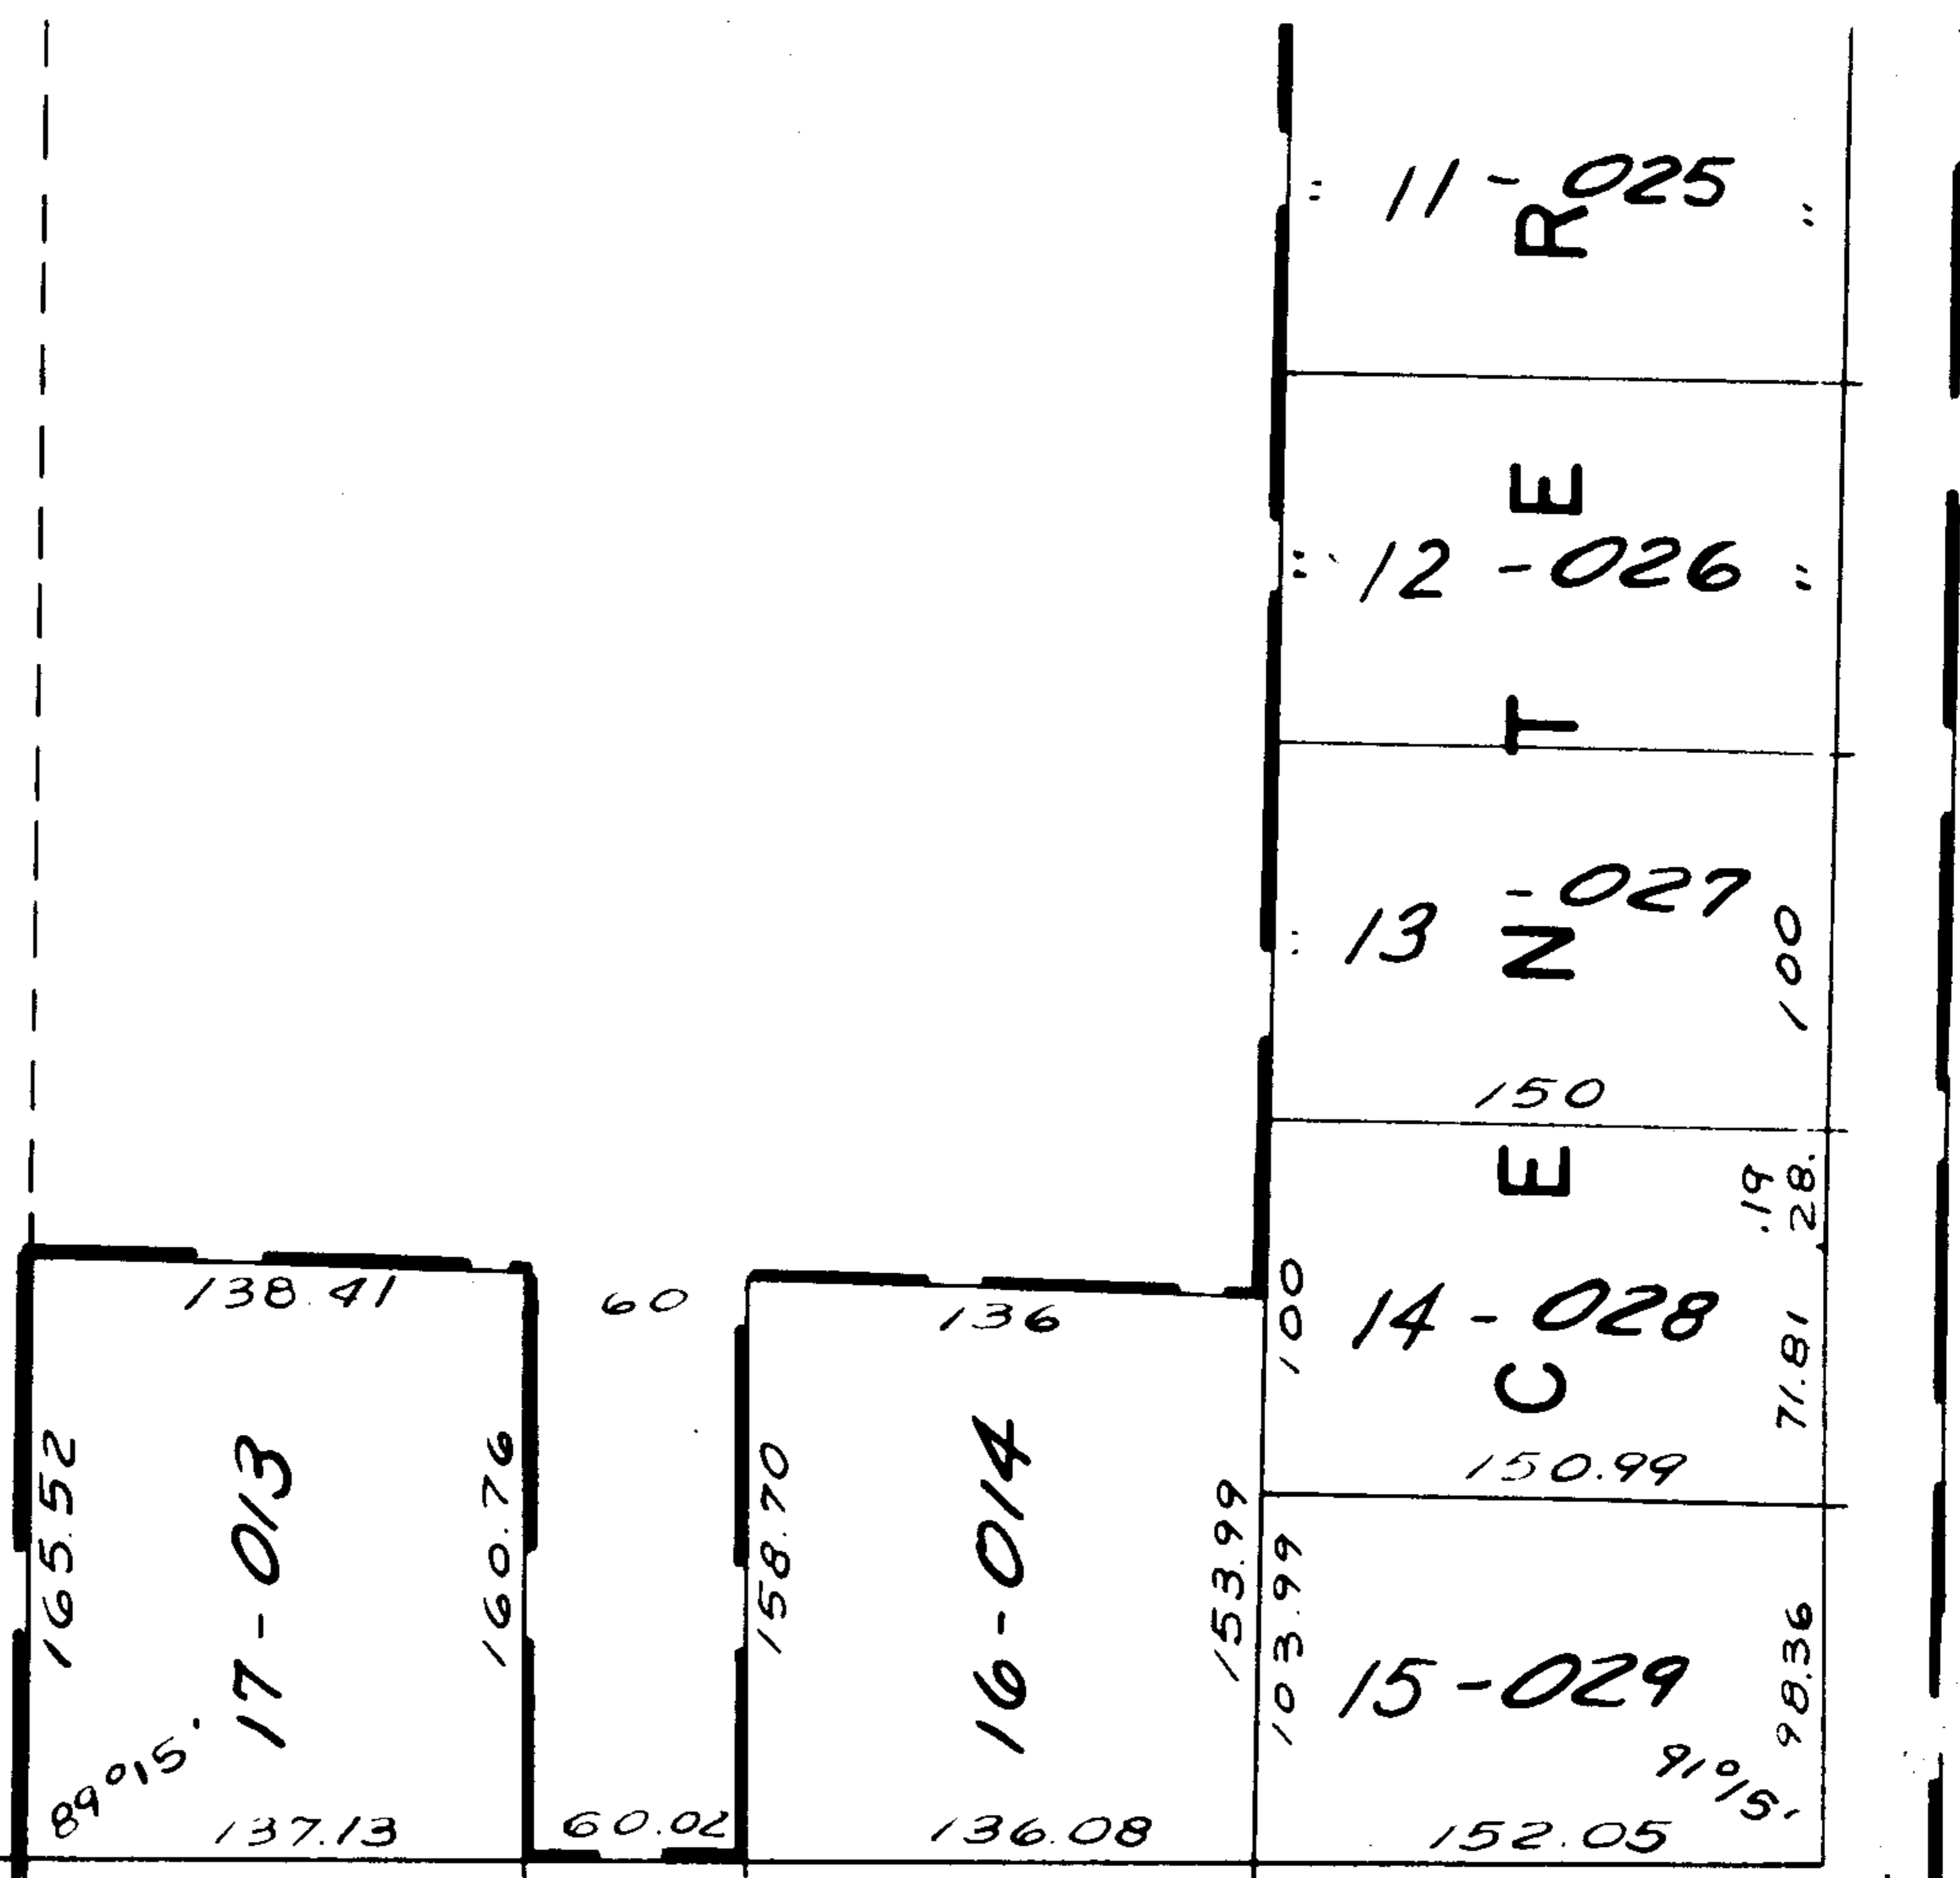

1940

APPROVED  
LORAIN CO.  
MAP DEPT.  
DATE 7-15-68  
4-00-016-F  
BY *Robert*

7-14-86 S.S.

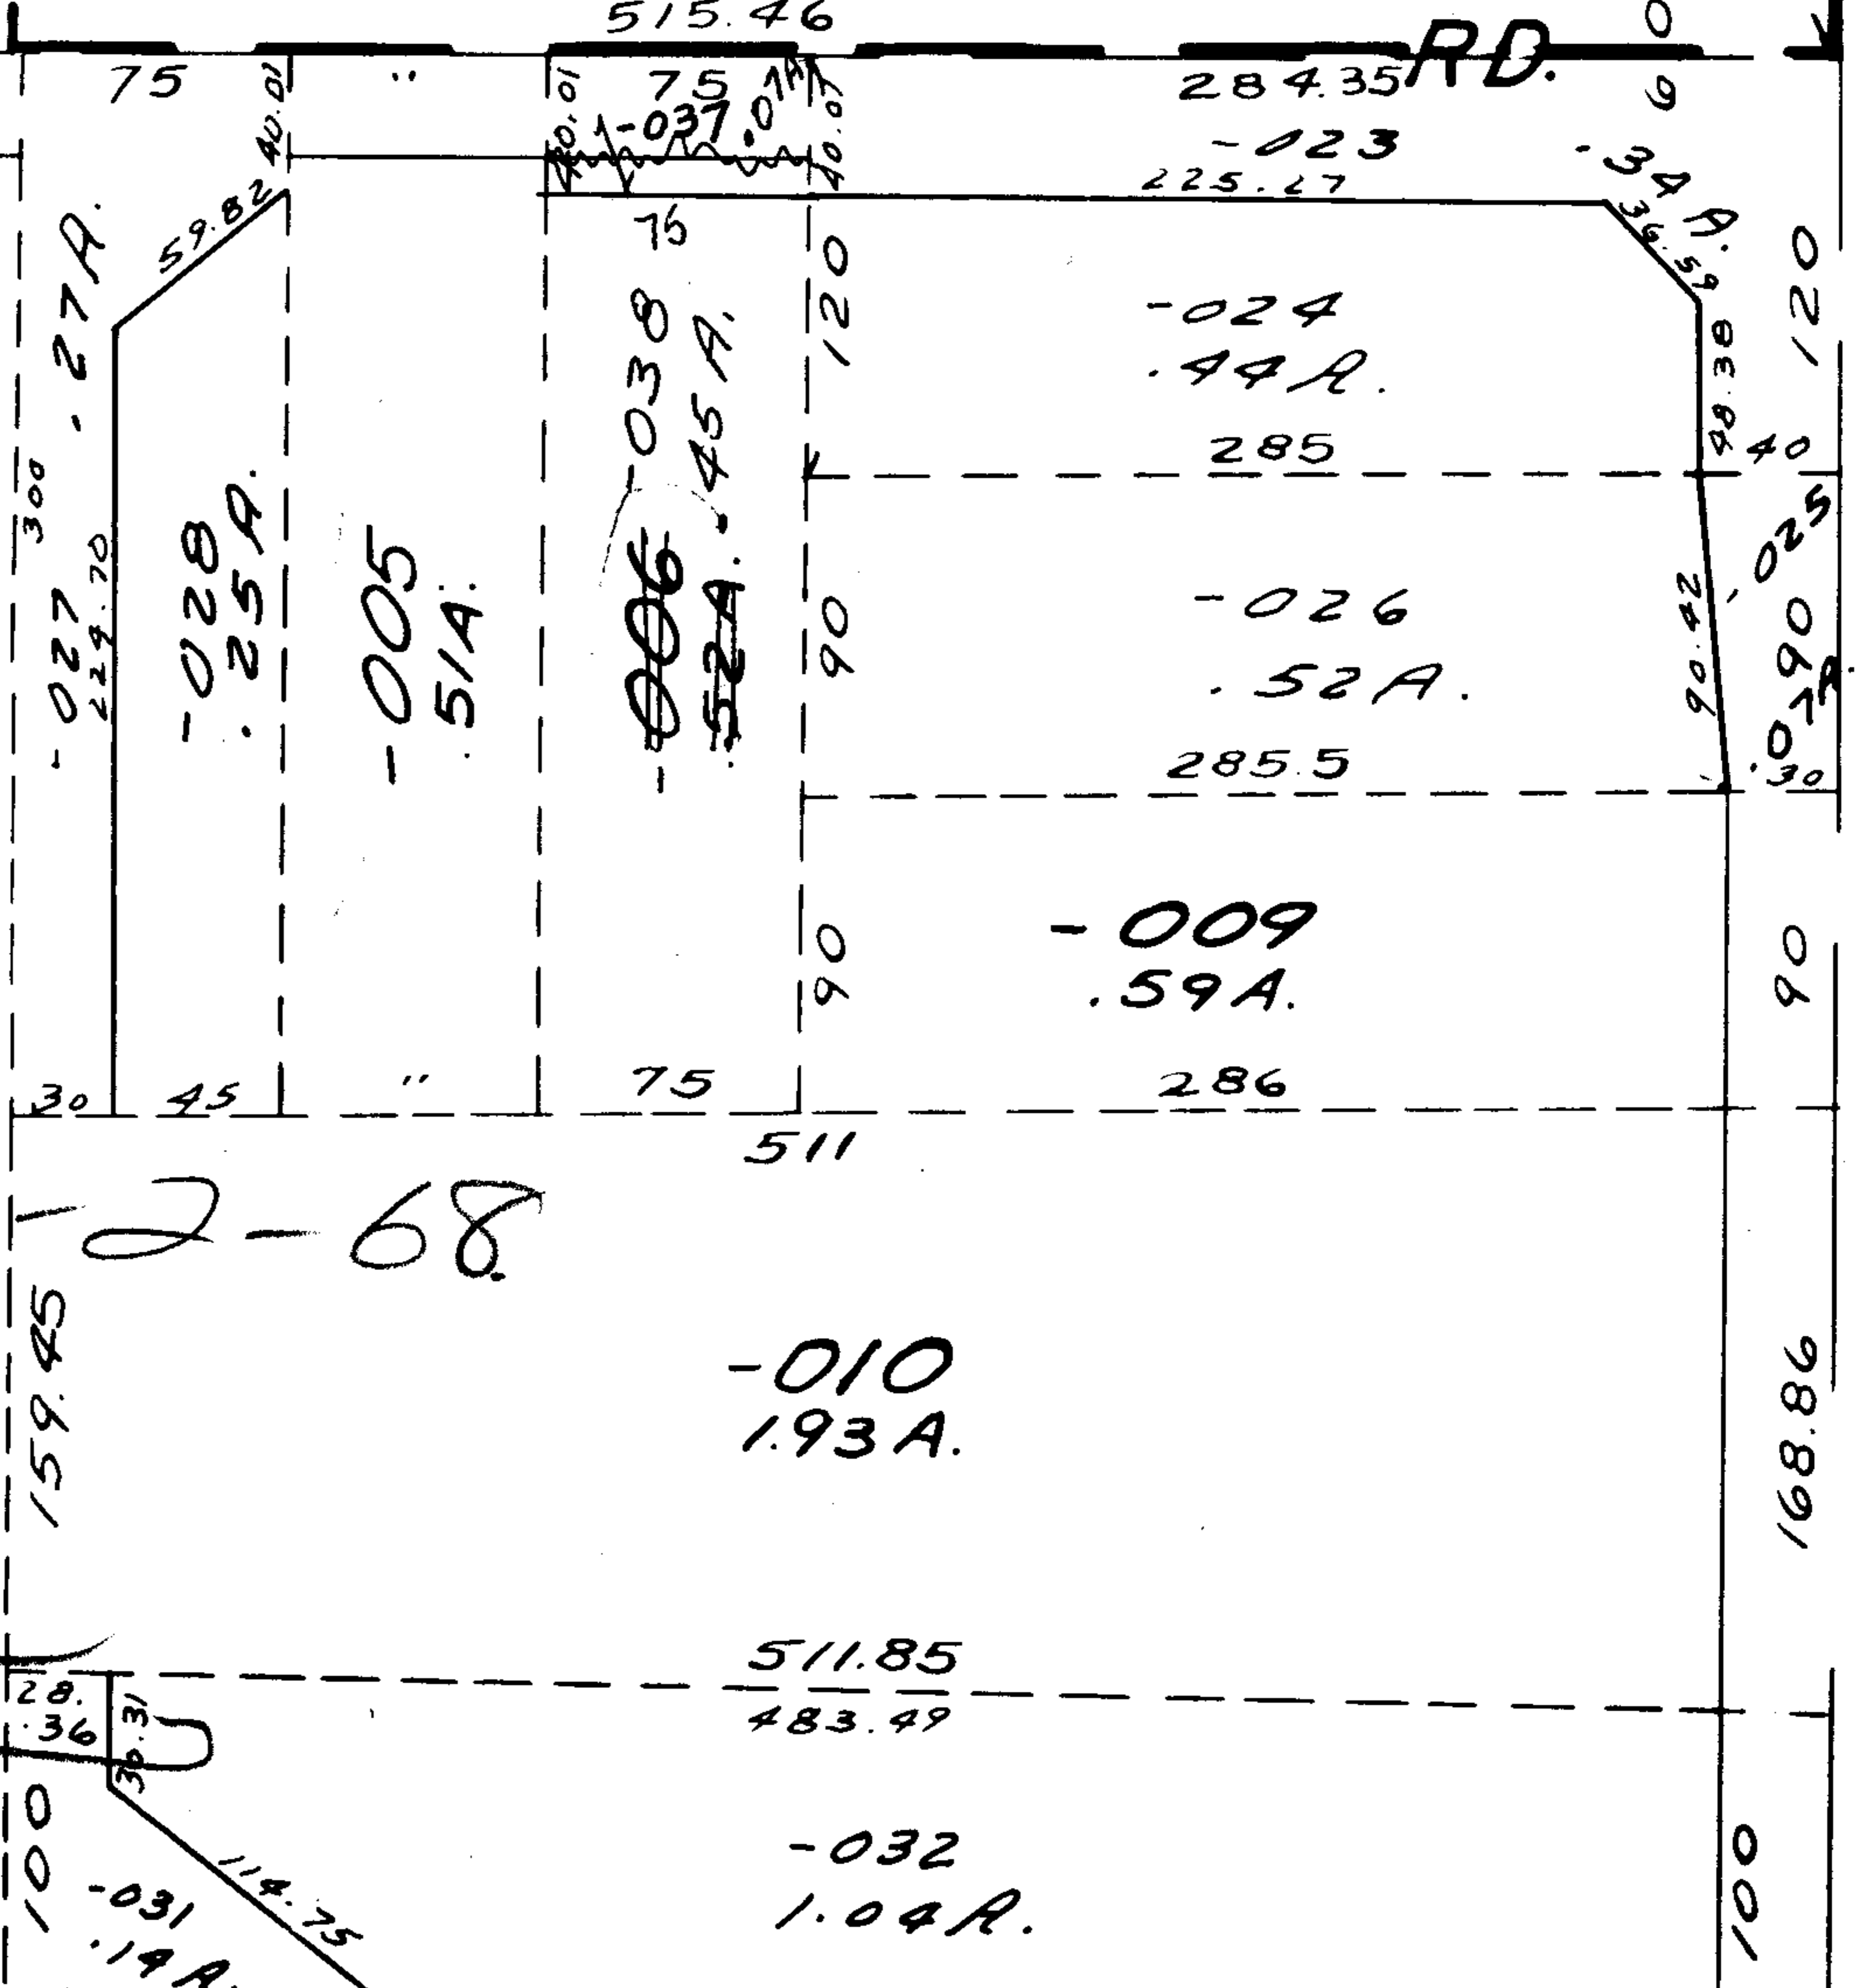

*Done 8-2-68*

*Jim Grace*