


SE

-001
4.60 A.

-027
.53 A.

MIDDLE RIDGE

AC. CORR.

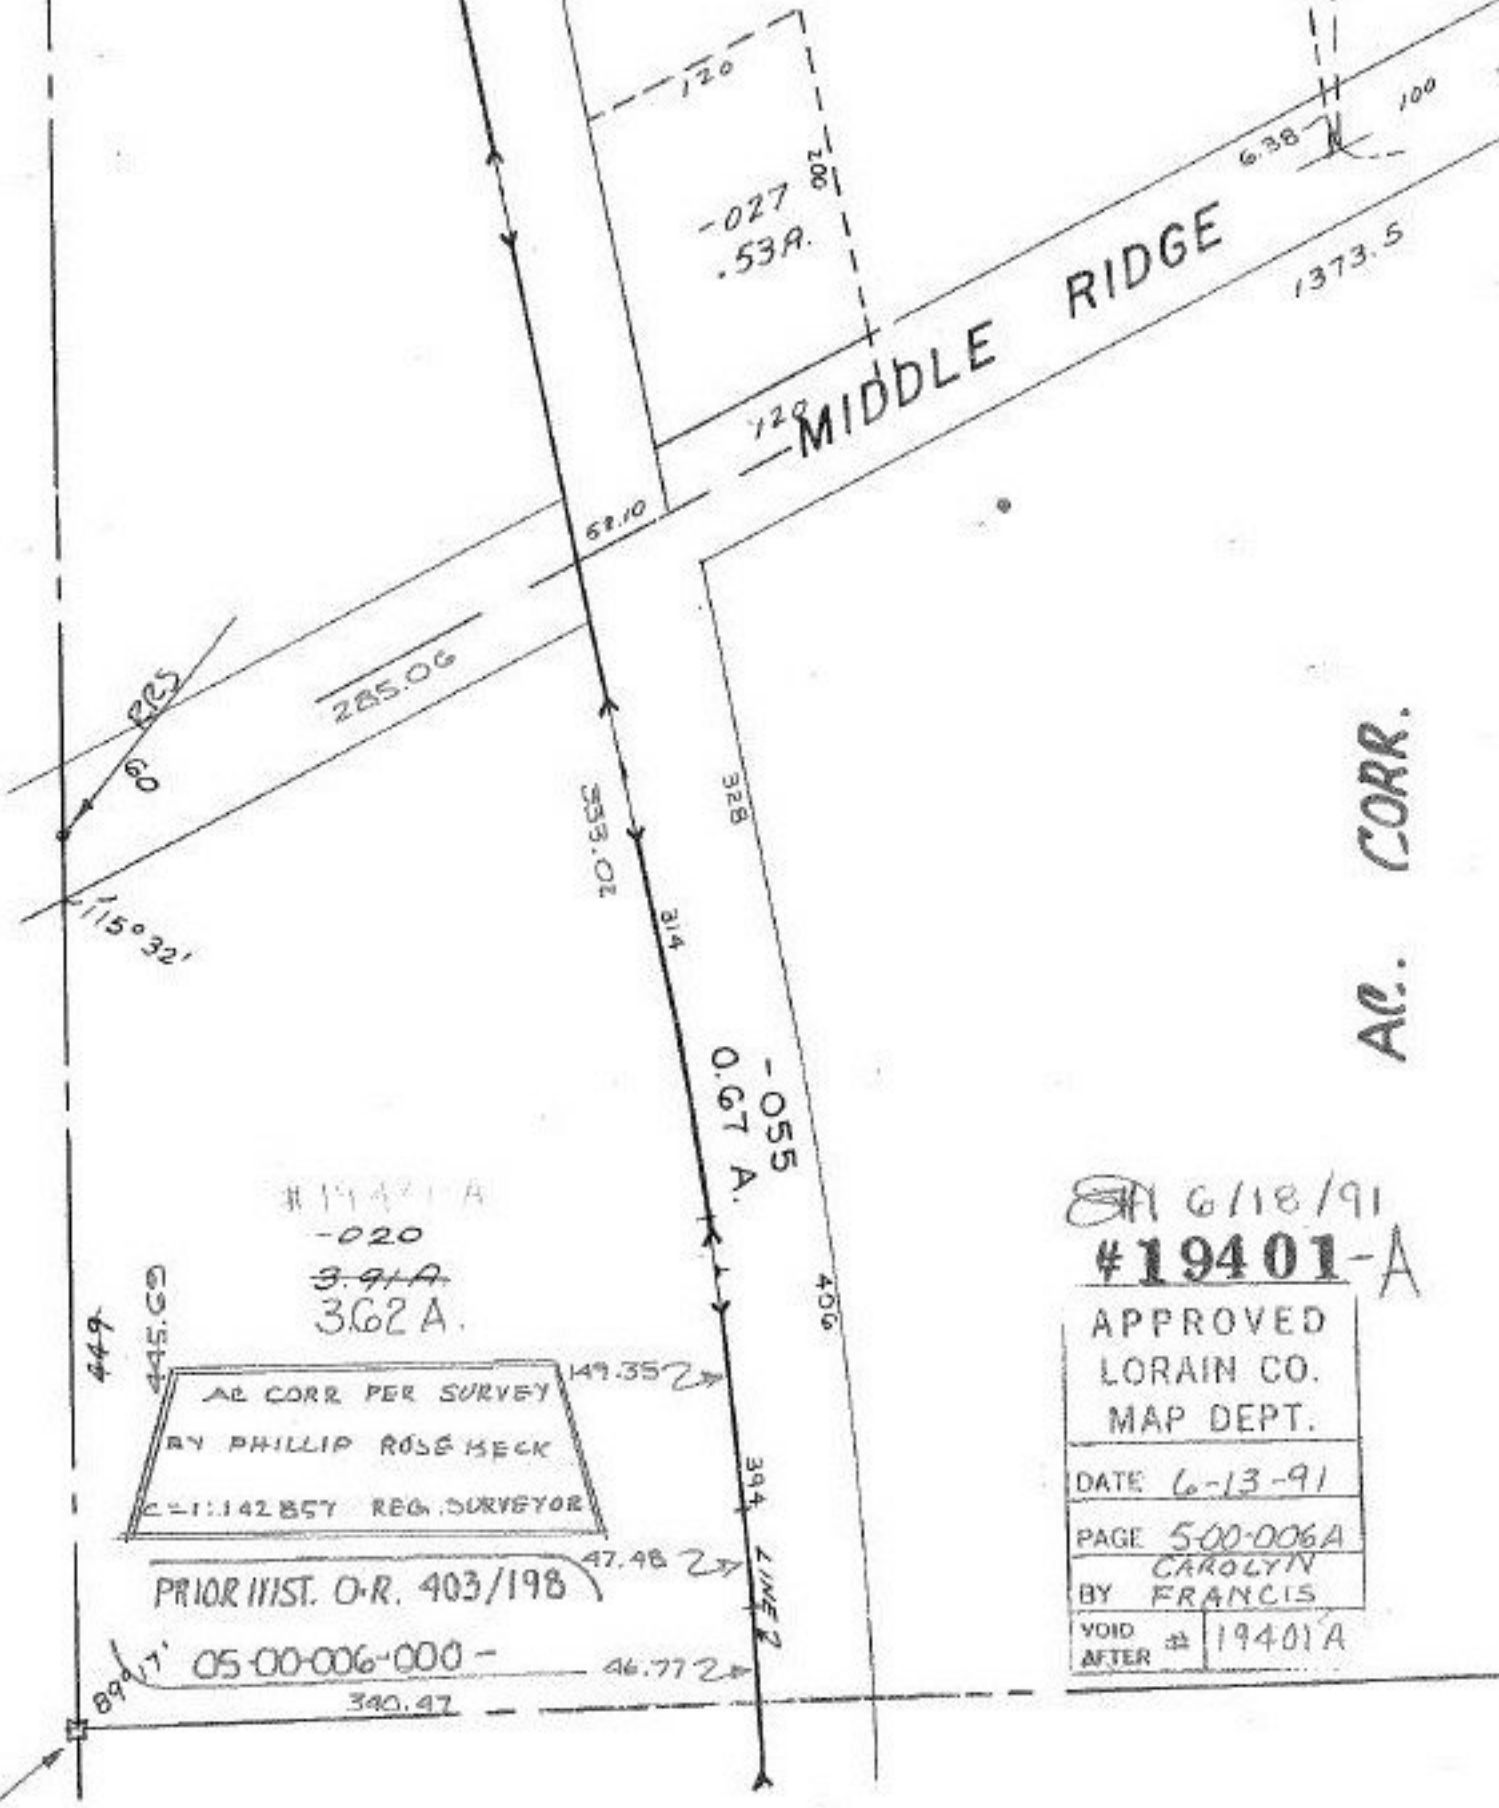

SA 6/18/91
#19401-A

APPROVED
LORAIN CO.
MAP DEPT.

DATE 6-13-91

PAGE 500-006A
CAROLYN
BY FRANCIS

VOID AFTER # 19401A