


ST 15-D

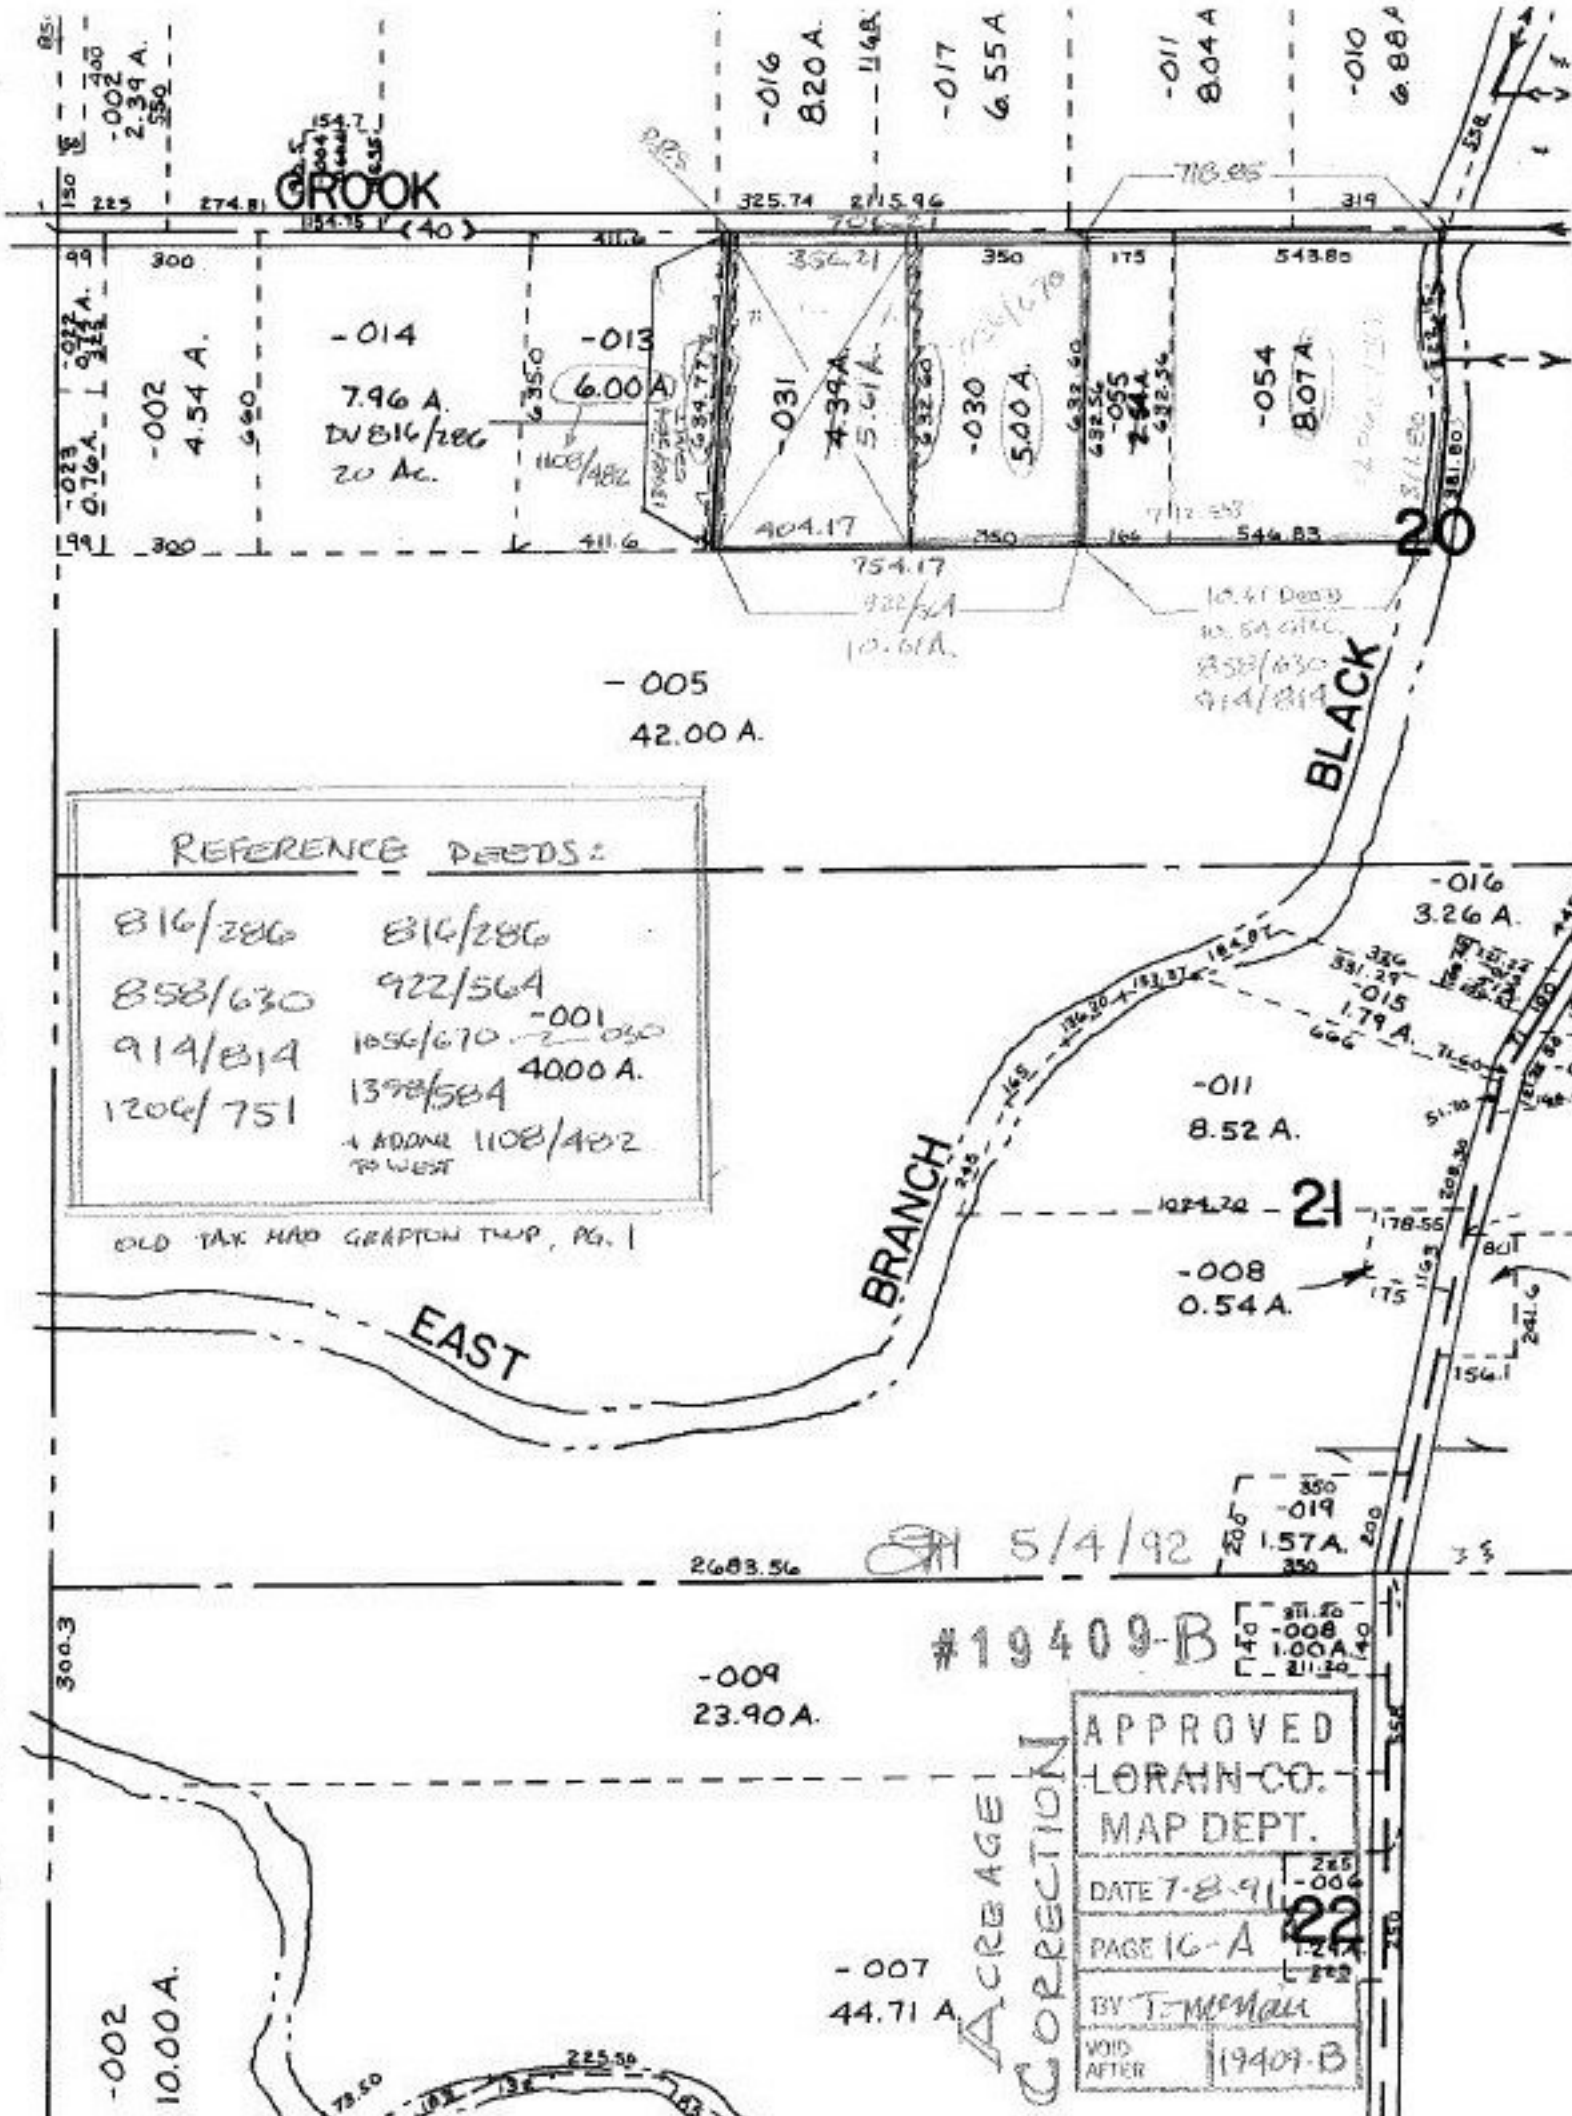

REFERENCE DEEDS:

816/286	816/286
858/630	922/56A
914/814	1056/670 -001
1206/751	1398/584 4000 A.
	1 ADDNL 1108/482 TO WEST

OLD TAX MAP GRAPTON TWP, PG. 1

5/4/92

#19409-B

APPROVED	
LORAIN CO. MAP DEPT.	
DATE 7-8-91	22
PAGE 16-A	22
BY T. McMan	
VOID AFTER	19409-B