


1941

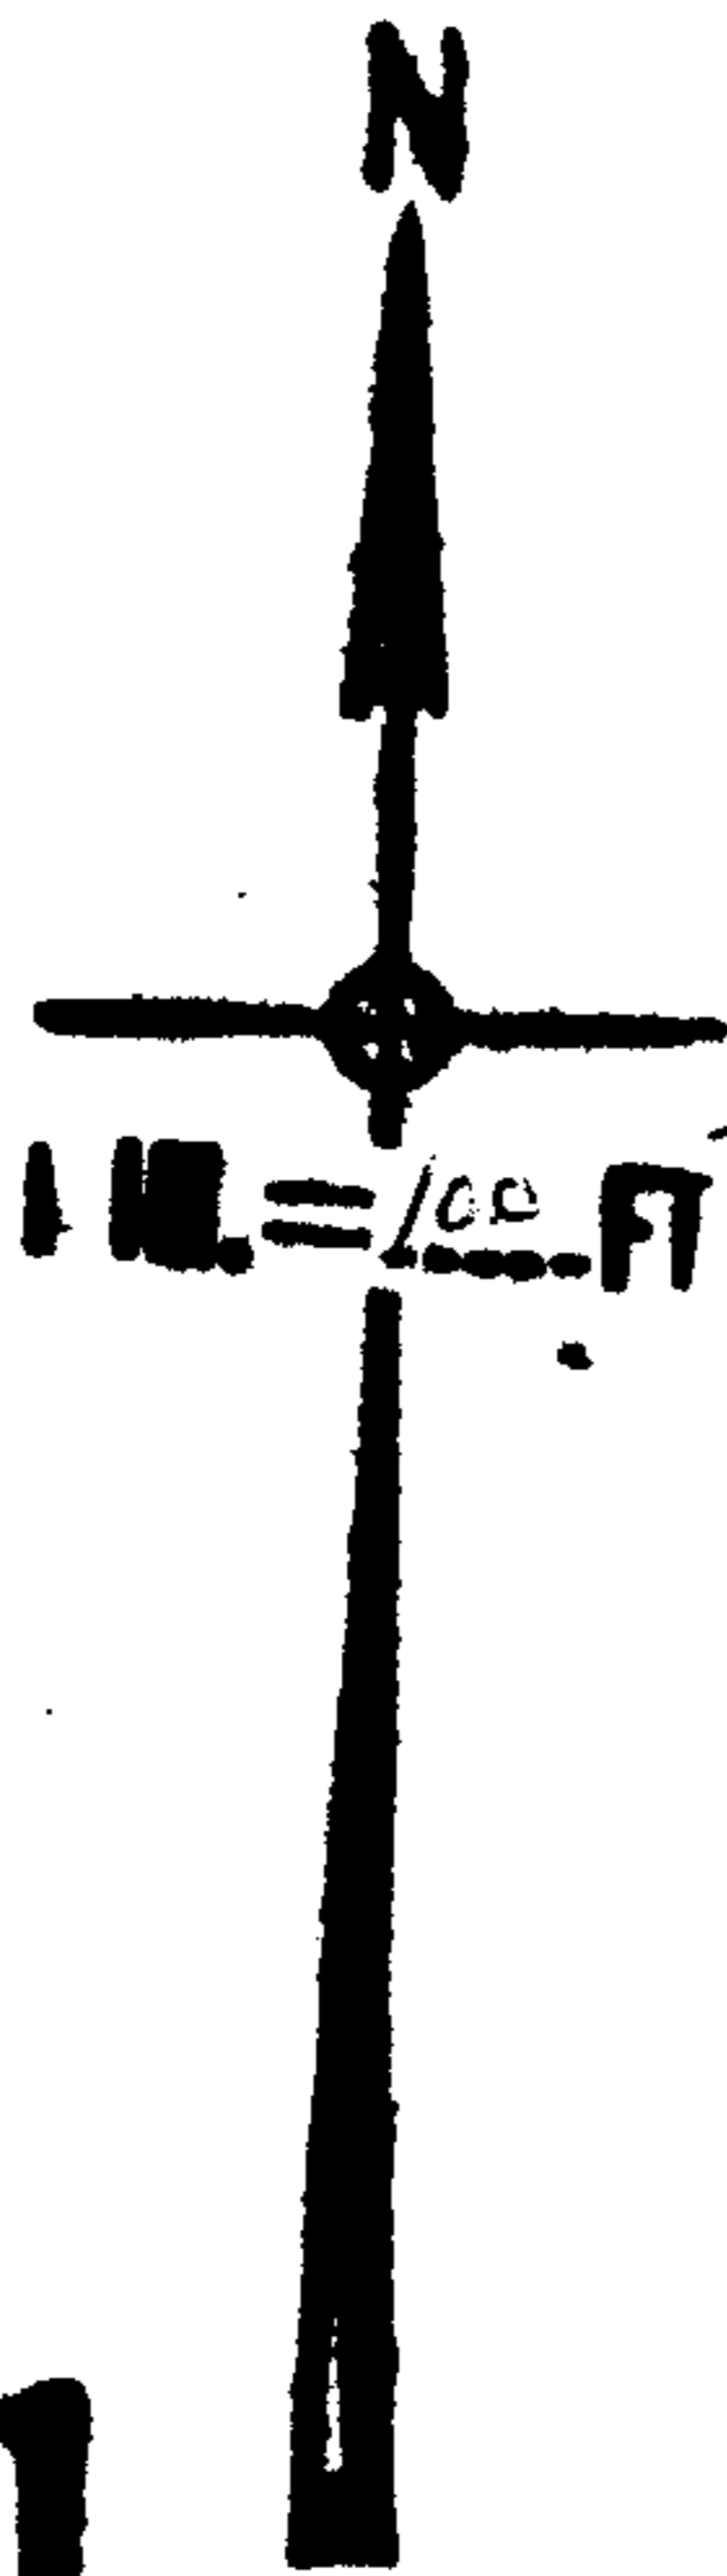

APPROVED
LORAIN CO.
MAP DEPT.
 DATE 7-15-68
 10-00-007-H.
 BY *Kollert.*

9/28/68 R.K.

SEE 10-00-007-G

D. J. 7-24-86

271.09
109.76
447.

-026
3.69 R.

-041
.44 A.

114.22

238.61

207.7

STA. 765

-024
2.99 R.

-040
.74 A.

158.50
315.42

836.09 297.85

~~-018~~
~~800 A.~~

156.92
822.40

239.78

108.39

211.01

148

-021
.58 R.

179.86
180

-042
.82 A.

-019
.67 A.

250

250

172.41

Var 10' 0" 9/16
305.3

CLEVELAND

OBERLIN

282.74
160.19 58.51

242.05

-019
.55 A.

280.4

-020
1.35 A.

92.1

180.0

37.3