


14.44  
36.26

5.62  
6.00

6.00  
11.00  
11.3  
3.8  
7.5

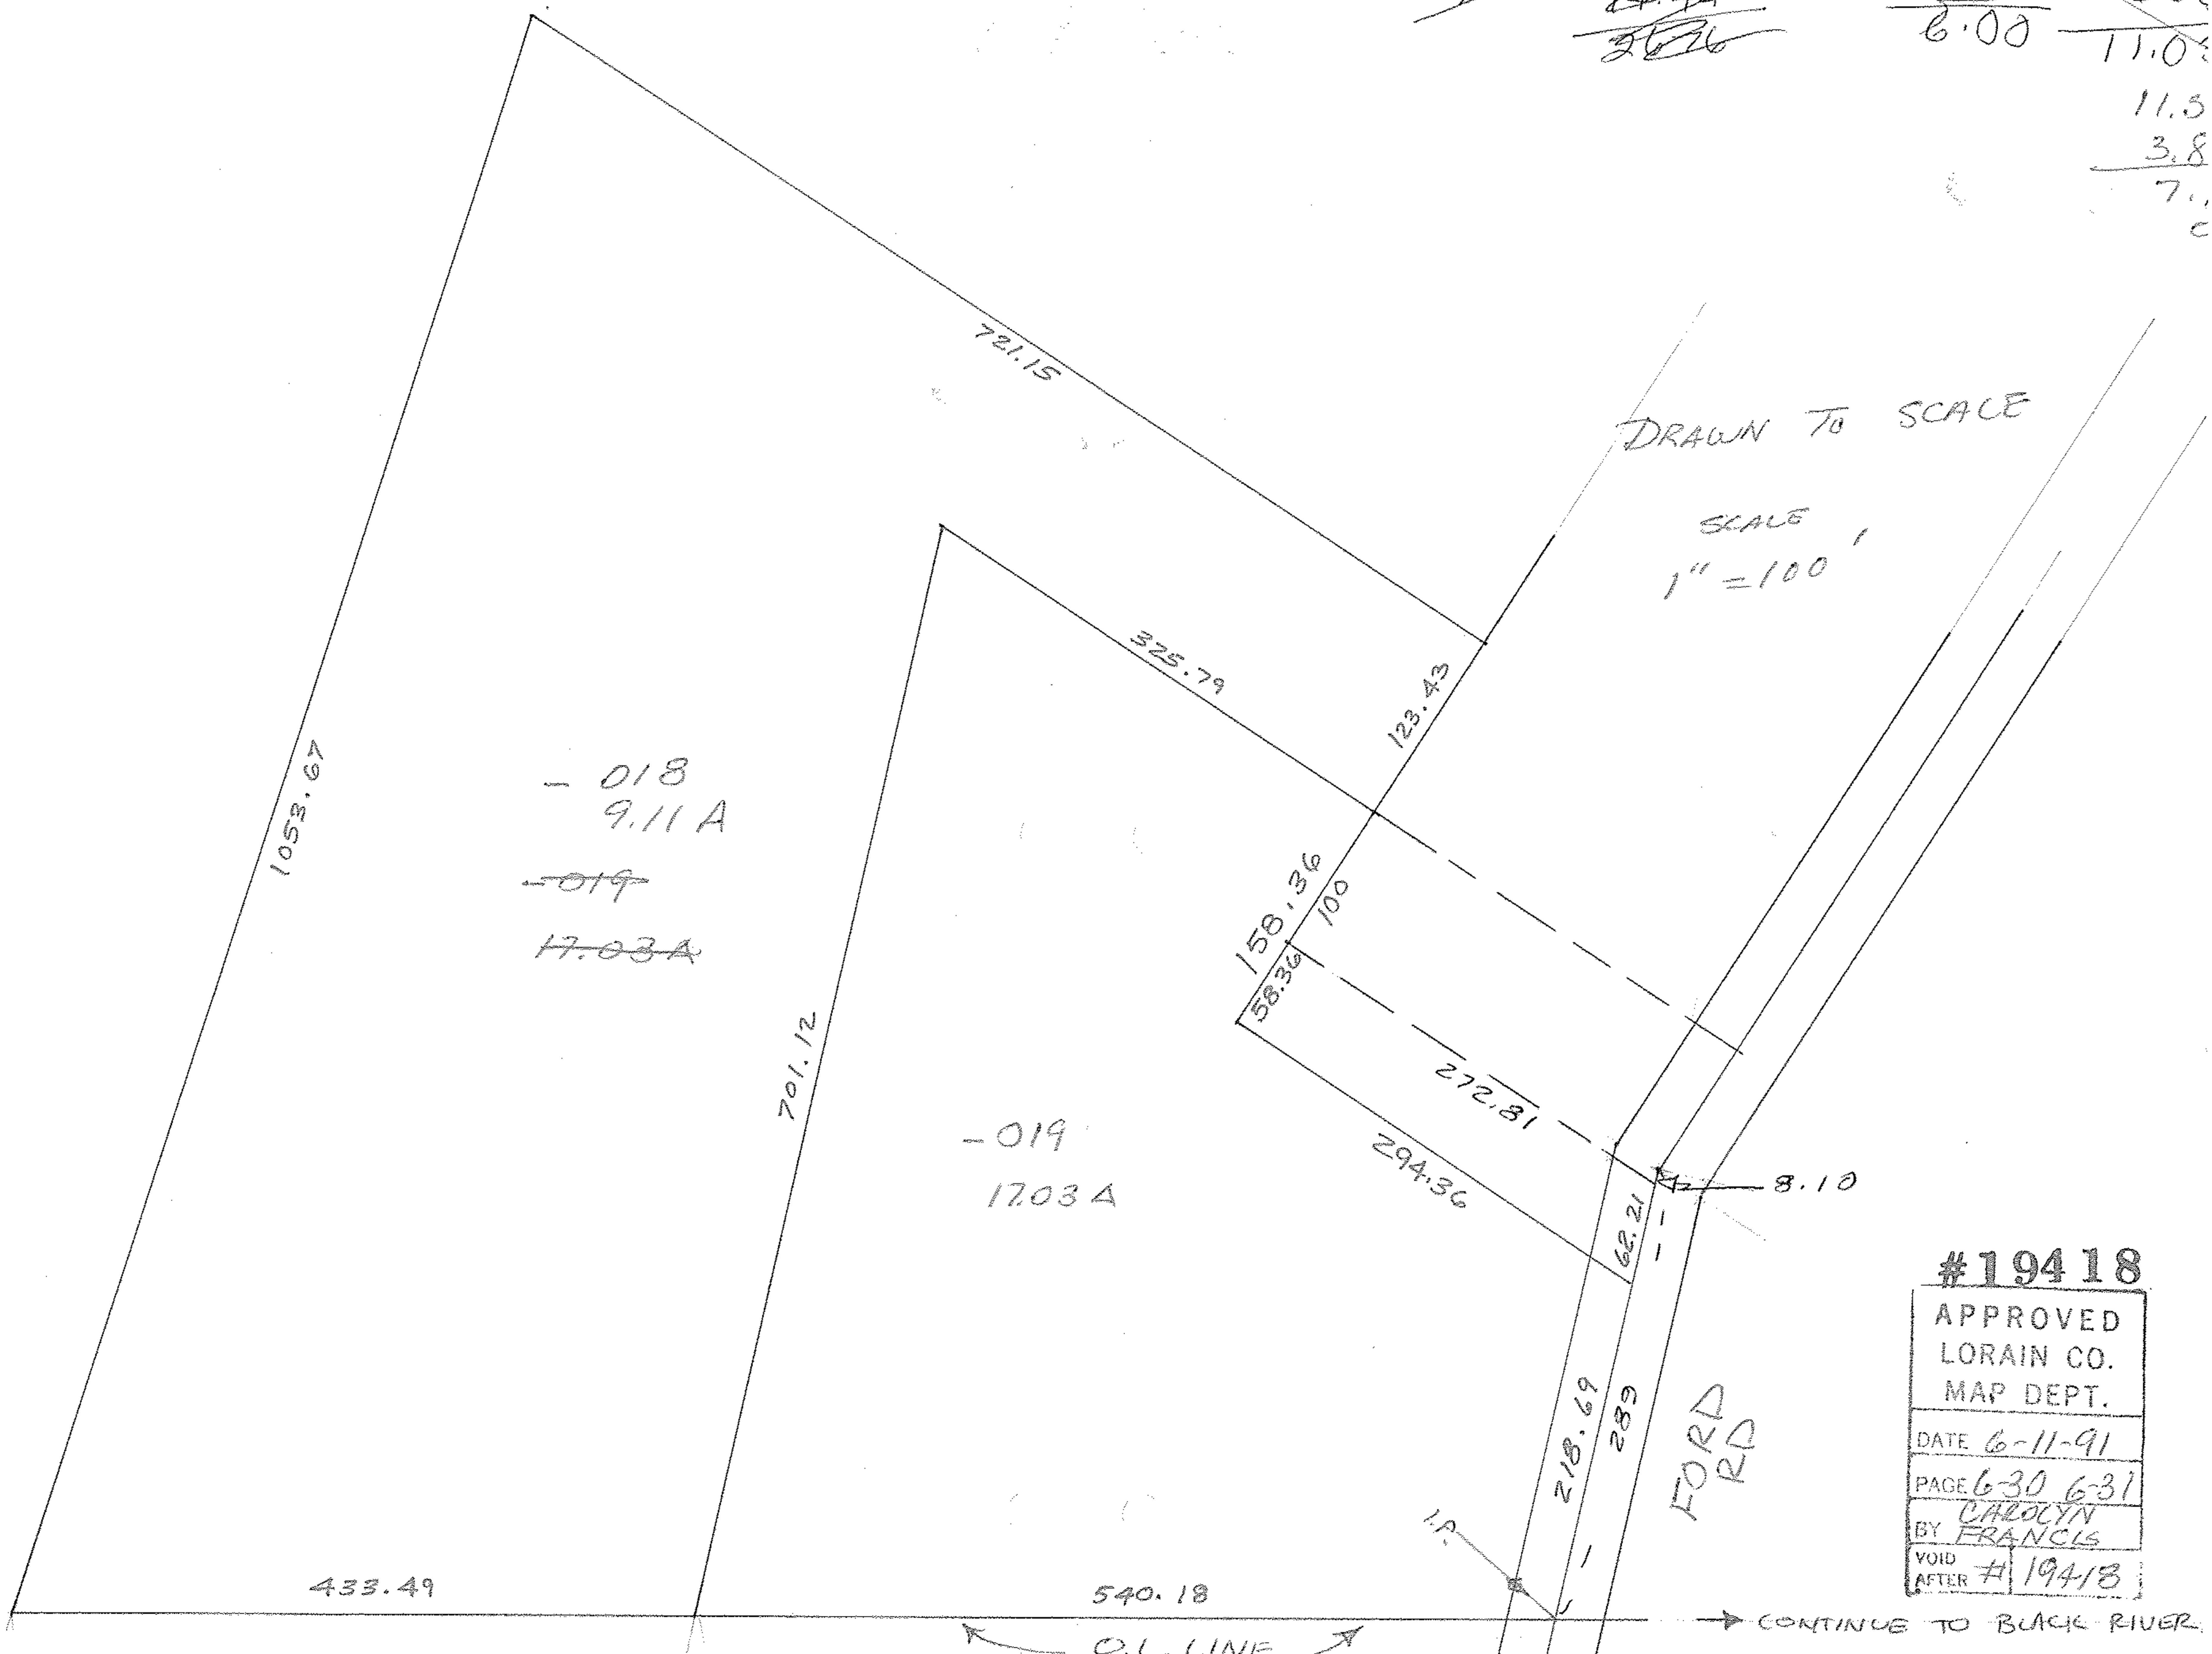

1053.67

- 018  
9.11 A  
~~- 019~~  
17.03 A

701.12

- 019  
17.03 A

721.15

325.79

123.43

158.36  
58.36  
100

272.81

294.36

DRAWN TO SCALE

SCALE  
1" = 100'

8.10

62.21

218.69

289

FORD RD

433.49

540.18

O.L. LINE

CONTINUE TO BLACK RIVER

#19418

APPROVED  
LORAIN CO.  
MAP DEPT.

DATE 6-11-91

PAGE 6-30 6-31

BY CAROLYN  
FRANCIS

VOID  
AFTER # 19418