

-006  
5.00 A.

82.00 A  
.02 A  
81.98 A

1462.31

20


34.14

34.09

-010  
0.02 A

20

147.90

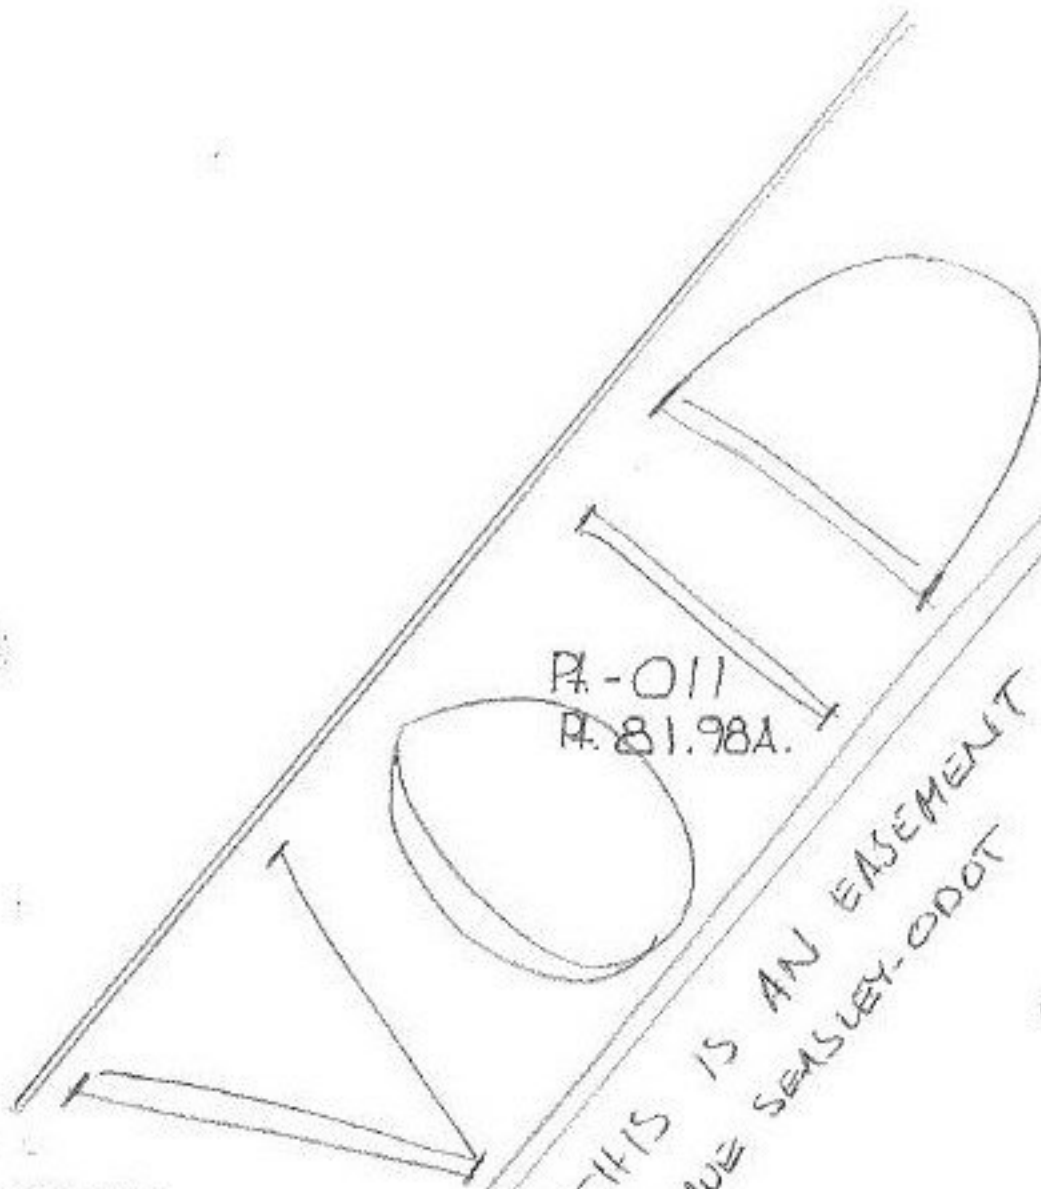

R-011  
R. 81.98A.

THIS IS AN EASEMENT  
DAVE SEASLEY-0007

PER  
NOTE 11-X (CHANNEL)

6/19/91 T.M.

-007  
82.00 A.

ABBE RD ST. RI 301

03-00-018-000- PRIOR INST. 1264/146  
SURVEYED BY: STATE OF OHIO R/N PLANS  
LOR. 301 25.36 C=1:INF.

SA 10/31/91  
#19422

APPROVED
LORAIN CO.
MAP DEPT.
DATE 6-13-91
PAGE 3-00-018-B
CAROLYN
BY FRANCIS
VOID # 19422
AFTER