


SEE 12-00-007-B

5.89 A
4.00
1.89 A

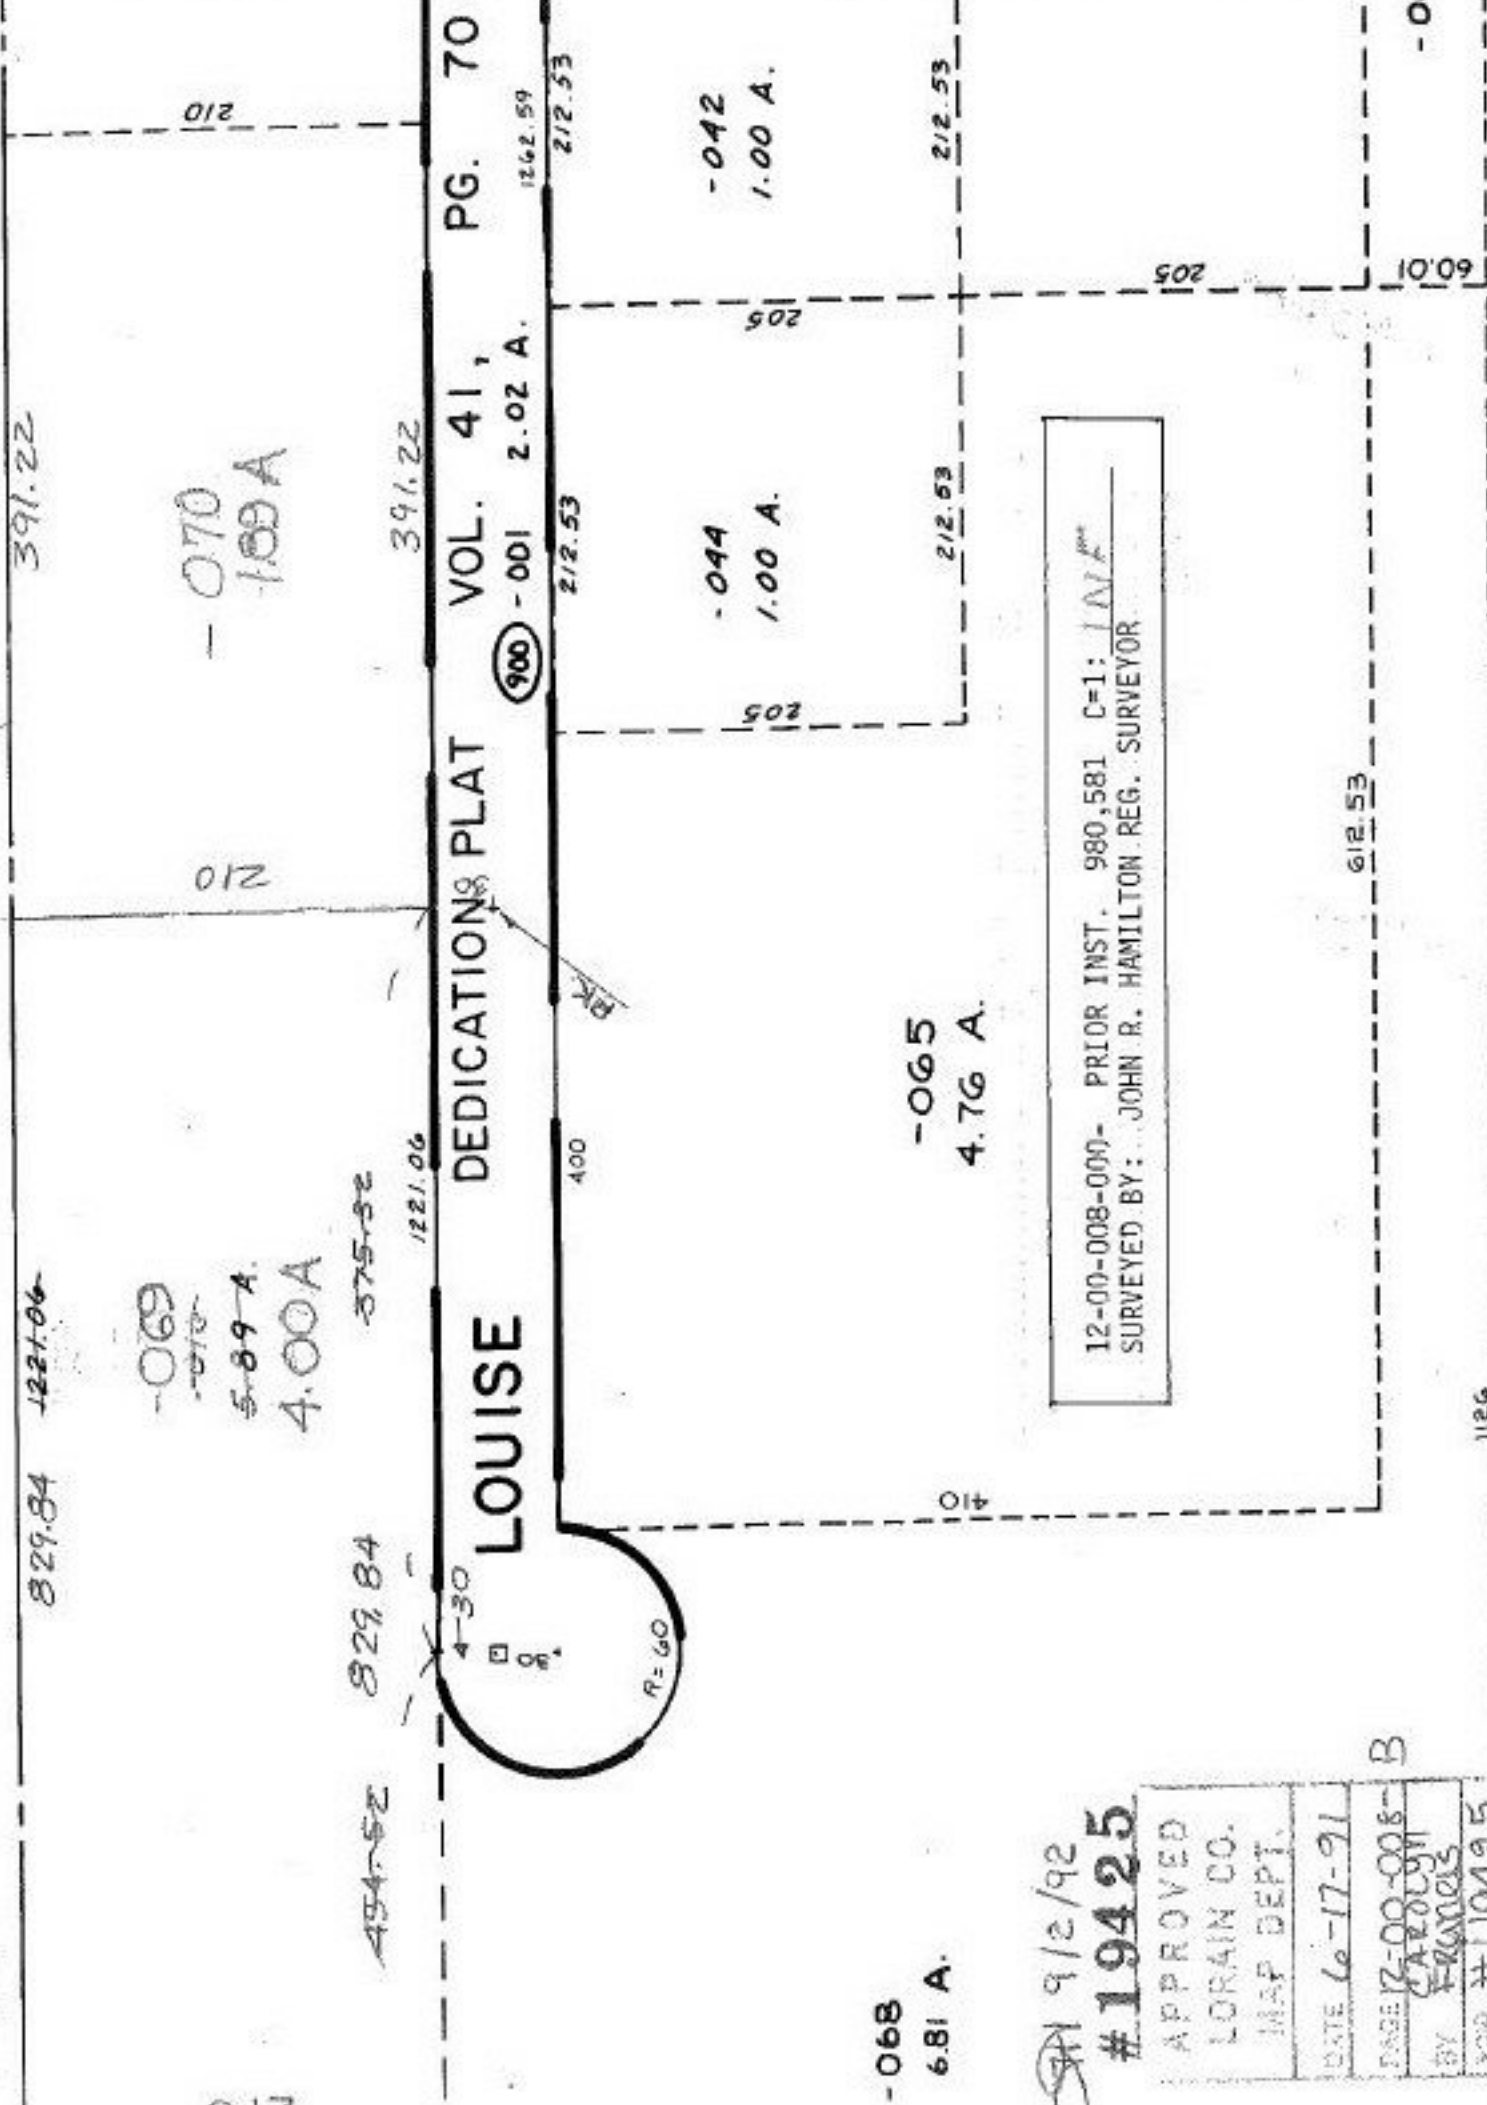

210

-068
6.81 A.

SA 9/2/92
#19425

APPROVED
LORAIN CO.
MAP DEPT.
DATE 6-17-91
PAGE 12-00-008-B
BY CAROLYN
FRANZIS
YOD #19425

12-00-008-000- PRIOR INST. 980,581 C=1: 1/4"
SURVEYED BY: JOHN R. HAMILTON REG. SURVEYOR

1126

1335.66

60.01

-06