


3445.2

-001
39.7

-006
29.48 F.

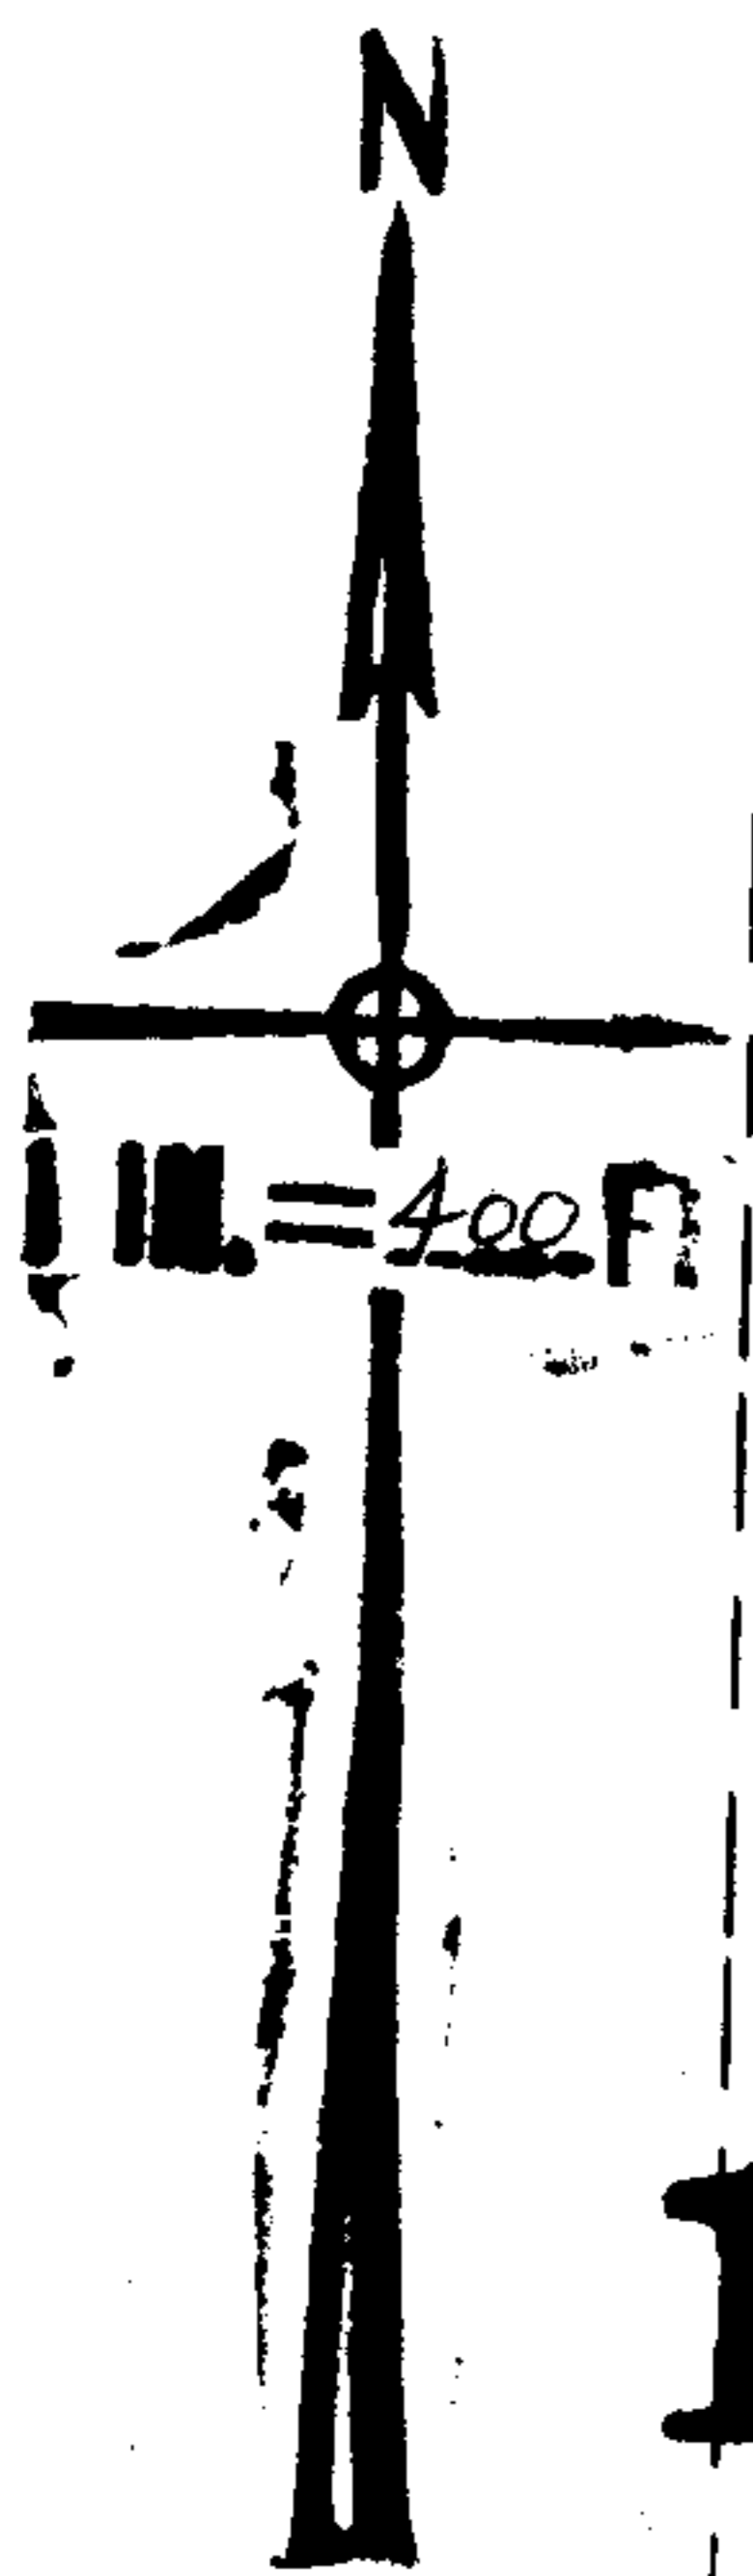

-001
74.58 F.

1944

APPROVED
LORAIN CO.
MAP DEPT.
 DATE 7-15-68
 18-B
 BY *H. Bollert*

50.00 F.

33

-007 2.60 F.

-014
36.66 A.
~~46.66 F.~~

10.38 F. V.

911.75

-013
10.00 A.

8 -001

-010
44.51 F.

S. S.

7-4-68

749.69

549.50
2677.92
502

20

-009
15.00 F.

784.17
100 L.

-004
12.50 F.

Done 7/21/68

-011
4.55 F.

-012
5.45 F.

DINA - NORWALK

340.75

C-479.42

257

308.34

1158.7

Pt. 18-00-034-502-001
Pt. 13.69 F.

SEE 18-F