


SEE 2-01-006-F
 SIZE CORRECTION PER DEED
 Vol. 1373 Pg. 680

20 : X :: 50 : 0.69

$\frac{0.69 \times 20}{50} = .276 = X$

10 : X :: 50 : .69

.138

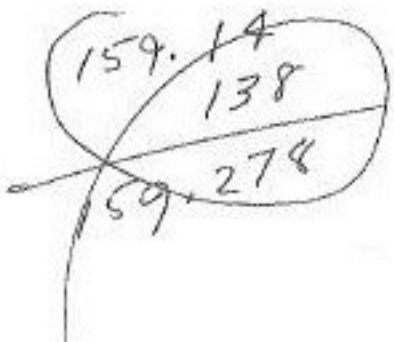

SIZE CORRECTION

$\frac{159.14}{158.45} = .69$

158.45
 83
 14
 10/69/91
 19450-A
 28

APPROVED LORAIN CO. MAP DEPT.	
DATE 6/27/91	
PAGE 2-01-006-D	
BY F. COLBERT & T. H.	
VOID AFTER	19450-A