


GARFIELD, W. RD

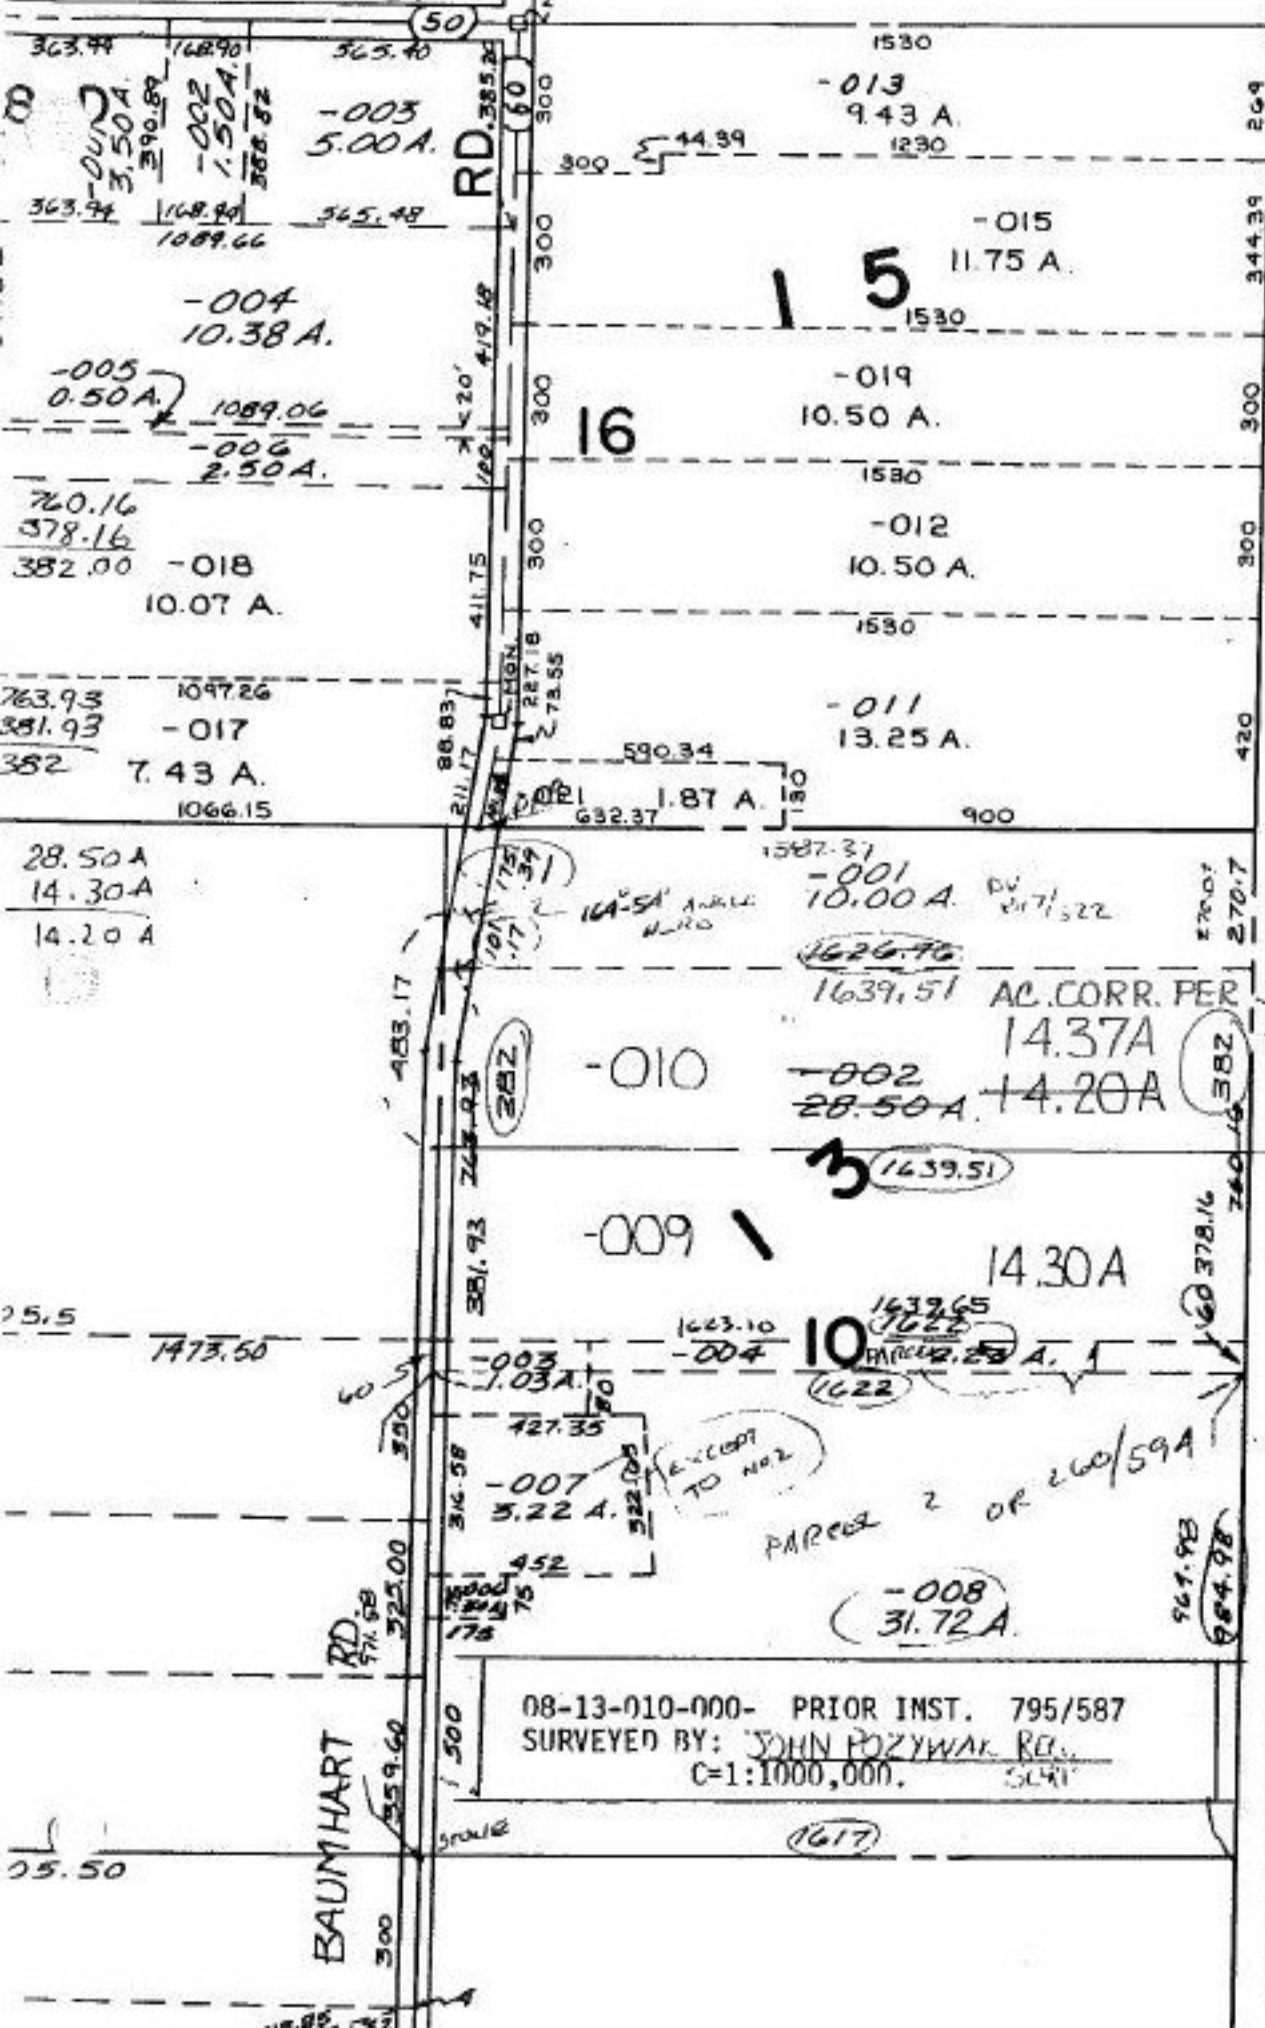

08-13-010-000-010  
 AC. CORRECTION

CL. 1:1NF  
 JOHN POZYWAK 7/23/92  
 REG. SURVEYOR

**#19466A**

APPROVED
LORAIN CO.
MAP DEPT.
DATE 8-5-91
PAGE 8-4
BY FRANCIS
VOID AFTER # 19466-A

**#19457**

APPROVED
LORAIN CO.
MAP DEPT.
DATE 7-2-91
PAGE 8-4
BY FRANCIS
VOID AFTER # 19457