



ADDN.
-073

1

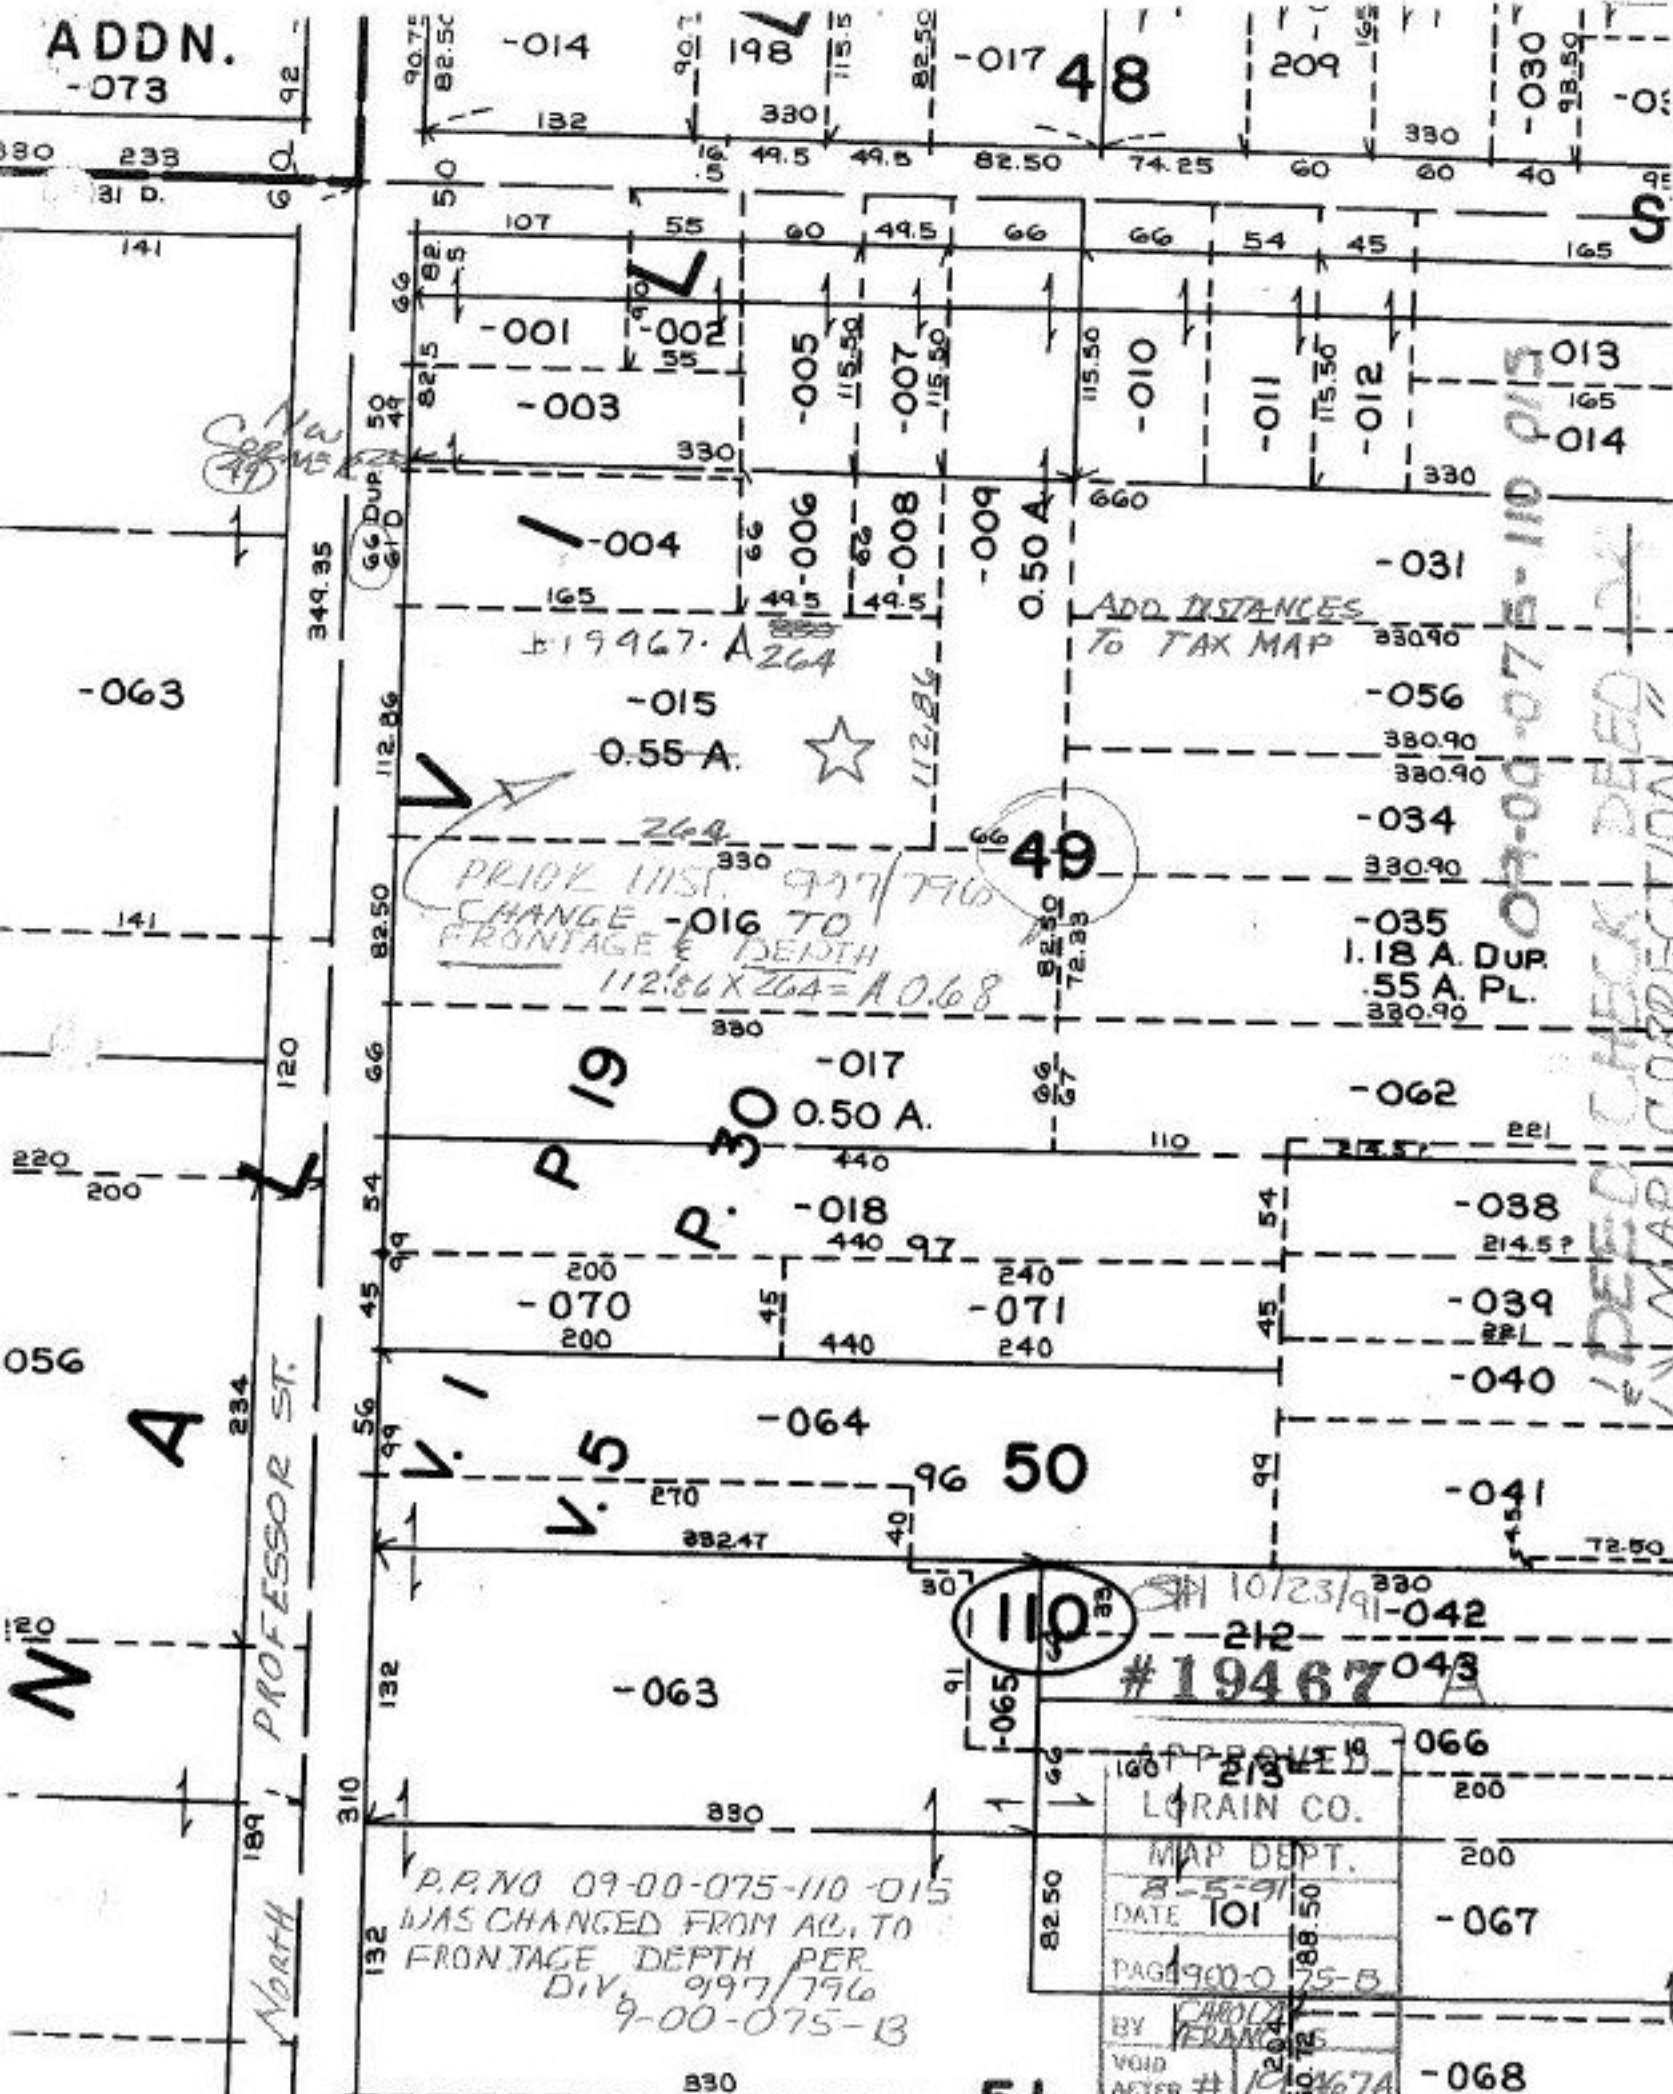

19967-A
264
-015
0.55 A. 
264
PRIOR HIST. 9/17/79
CHANGE -016 TO
FRONTAGE & DEPTH
112.86 X 264 = A.0.68

ADD DISTANCES
TO TAX MAP

09-00-075-110 P15

DEED CHECK DEED IN MAP CORRECTION

APPROVED	2/13/91
LORAIN CO.	
MAP DEPT.	
DATE	8-5-91
PAGE	101
BY	CAROL VERANO
VOID AFTER #	10/23/91

P.P. NO 09-00-075-110-015
WAS CHANGED FROM AC. TO
FRONTAGE DEPTH PER
DIV. 9/17/79
9-00-075-13

#19467-043