
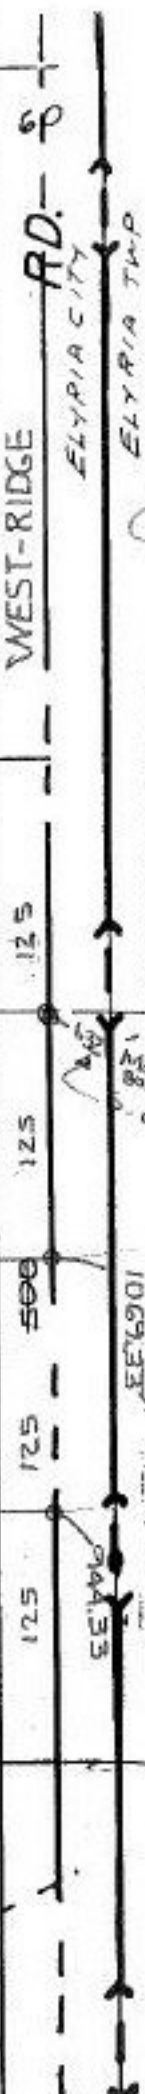


36.95 A  
 2.41 A  
 34.54 A

DEED 0.6026  
 0.6026  
 0.6026  
 0.6026  
 2.4104

2.41  
 .60  
 1.81  
 .60  
 1.21  
 .60  
 .61  
 0.60 DEED

-022  
 -018  
 36.95 A.  
 34.54 A.

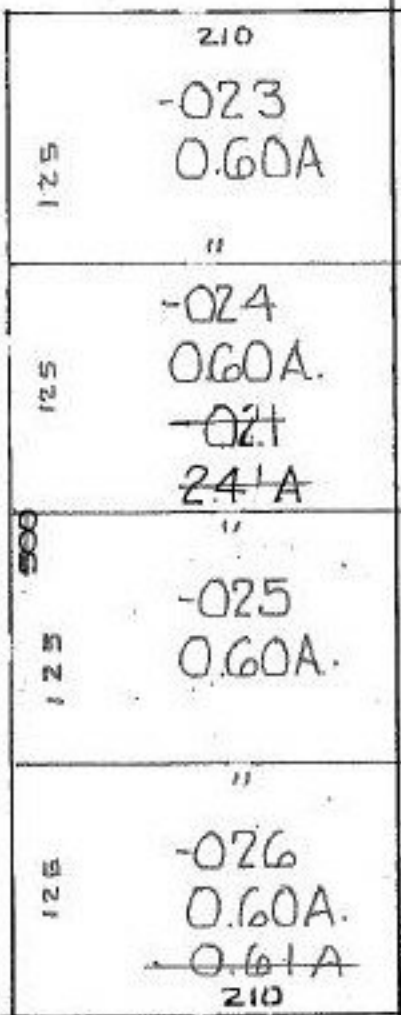

10/10/91  
**#19483**  
 APPROVED  
 LORAIN CO.  
 MAP DEPT.  
 DATE 7-24-91  
 PAGE 5-00-087  
 BY CAROLYN FRANCIS  
 VOID AFTER # 19483

~~#19386~~  
~~APPROVED~~  
~~LORAIN CO.~~  
~~MAP DEPT.~~  
~~DATE 5-22-91~~  
~~PAGE 5-00-087~~  
~~BY CAROLYN FRANCIS~~  
~~VOID AFTER # 19386~~

DIFFERENCES IN AC. IS DO TO SUBTRACTION AND ROUNDING

05-00-087-000- PRIOR INST. 1410/246  
 SURVEYED BY: KS ASSOC. C=1INF.  
 PRIOR INST. \_\_\_\_\_ C=1INF (1,2,3,4)  
 DV 1410/246

FROM + END OF ELYRIA MILAN RD WEST RIDGE RD