


RD.

89.6

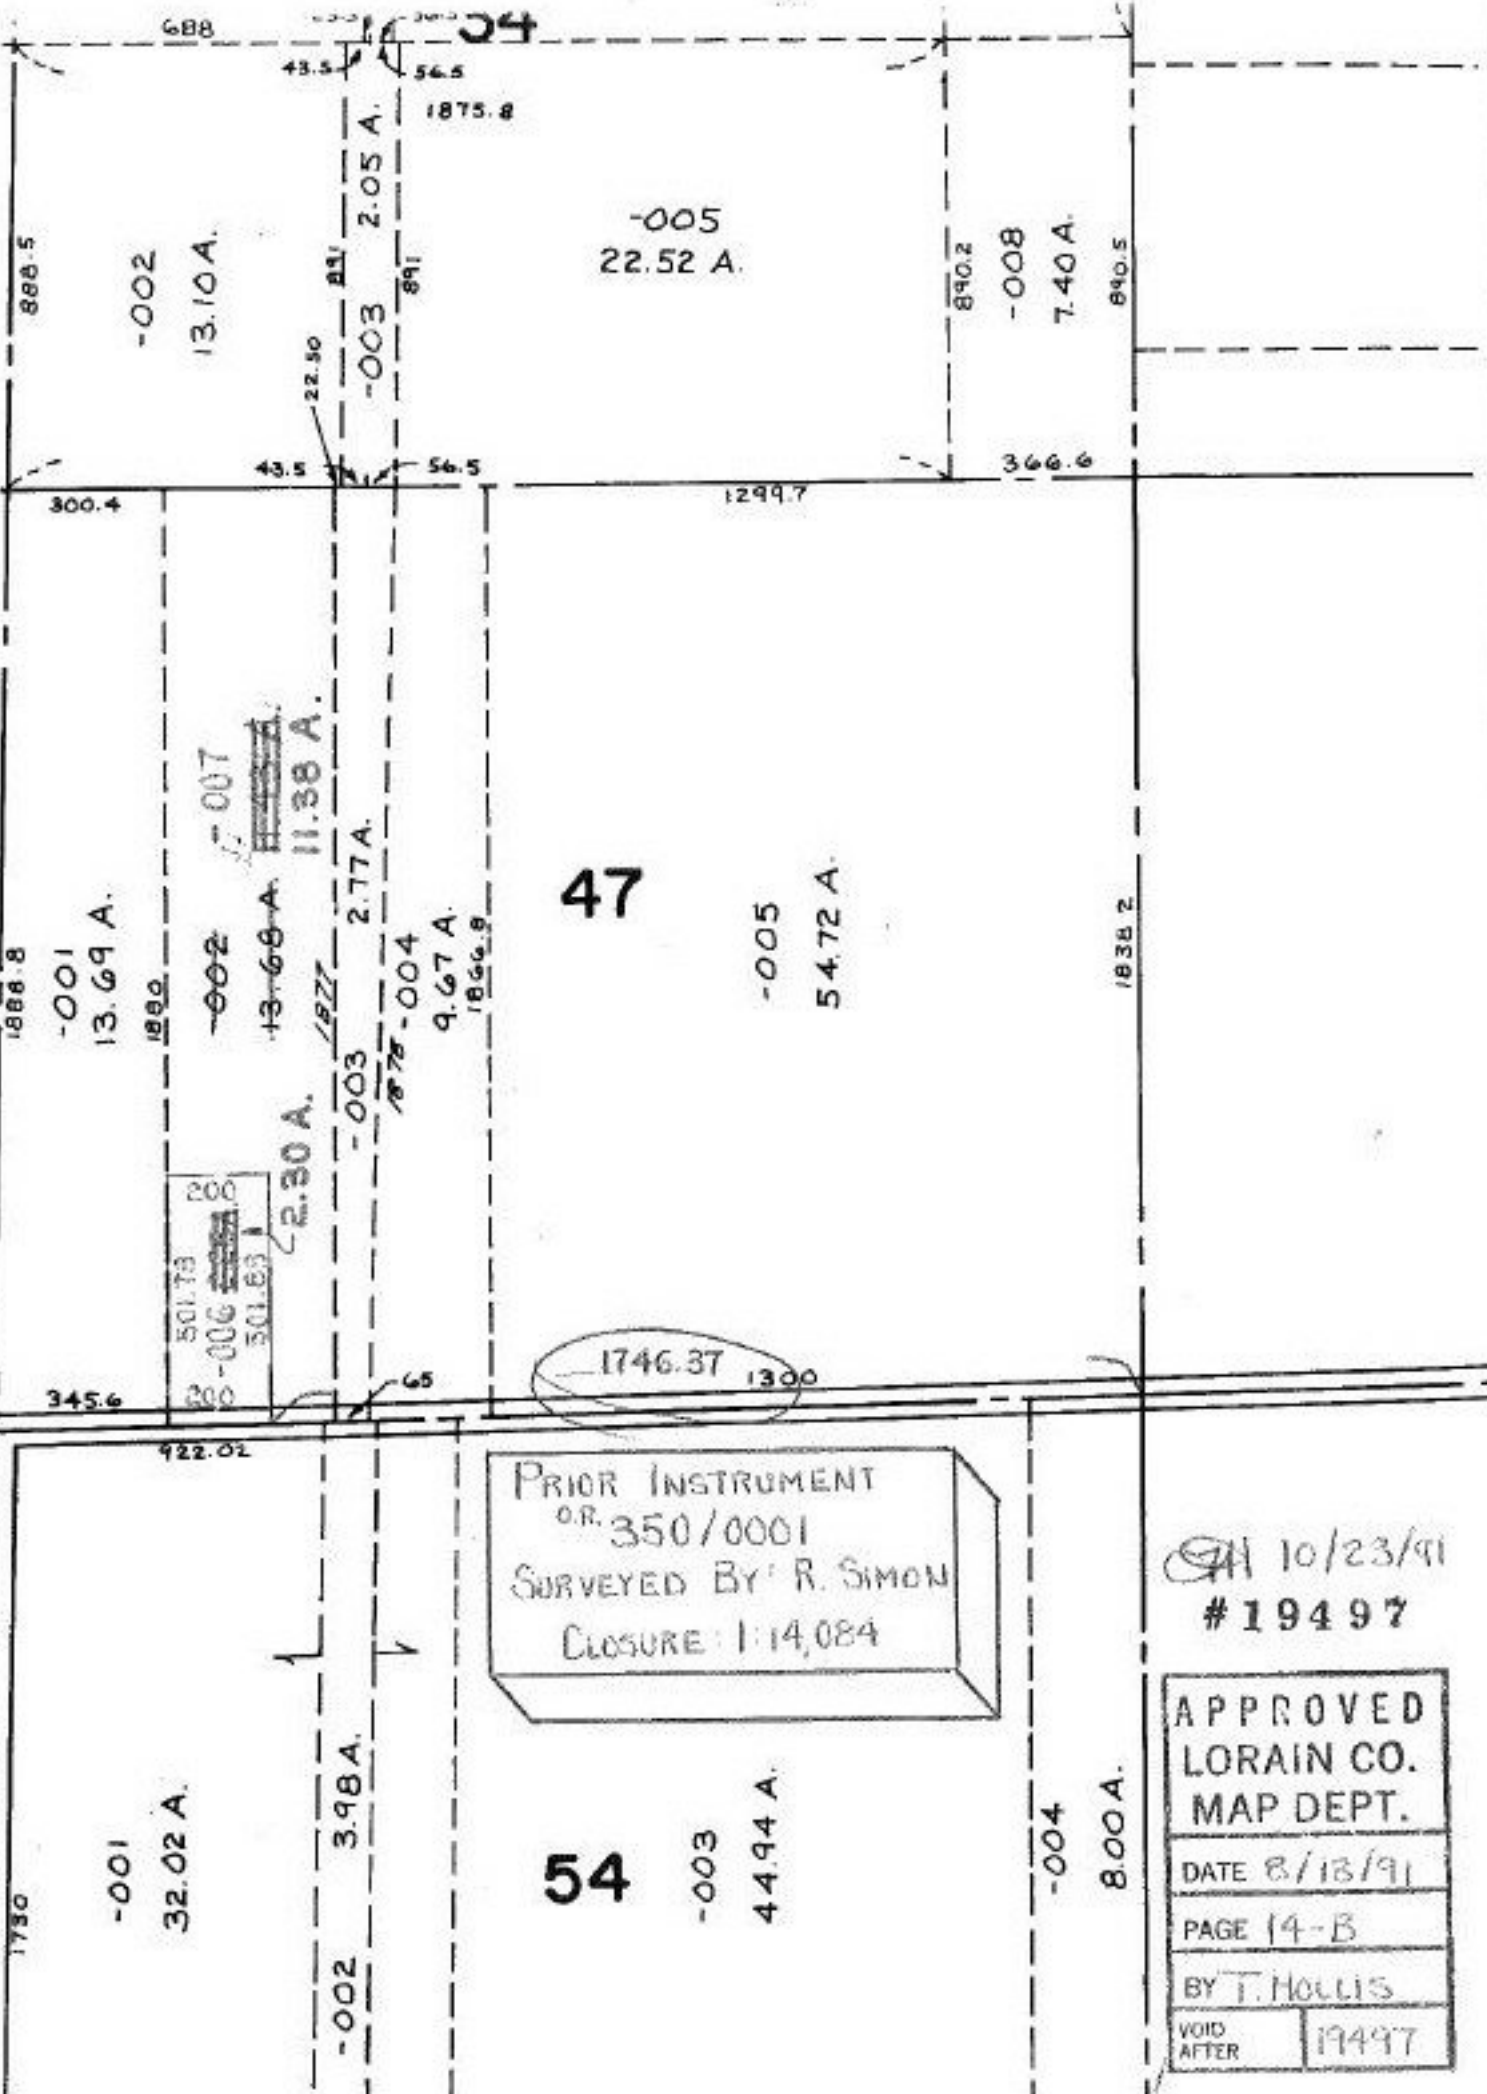

688

888.5

-002
13.10 A.

-005
22.52 A.

-008
7.40 A.

1888.8

-001
13.69 A.

47

-005
54.72 A.

1838.2

345.6

501.73
~~501.63~~
 501.63

-007

13.68 A.

11.38 A.

2.30 A.

-003
2.77 A.

-004
9.67 A.

1746.37

1300

PRIOR INSTRUMENT
 OR 350/0001
 SURVEYED BY R. SIMON
 CLOSURE: 1:14,084

54

-003
44.94 A.

-004
8.00 A.

10/23/91
 #19497

APPROVED
 LORAIN CO.
 MAP DEPT.

DATE 8/18/91

PAGE 14-B

BY T. HOLLIS

VOID
 AFTER 19497